


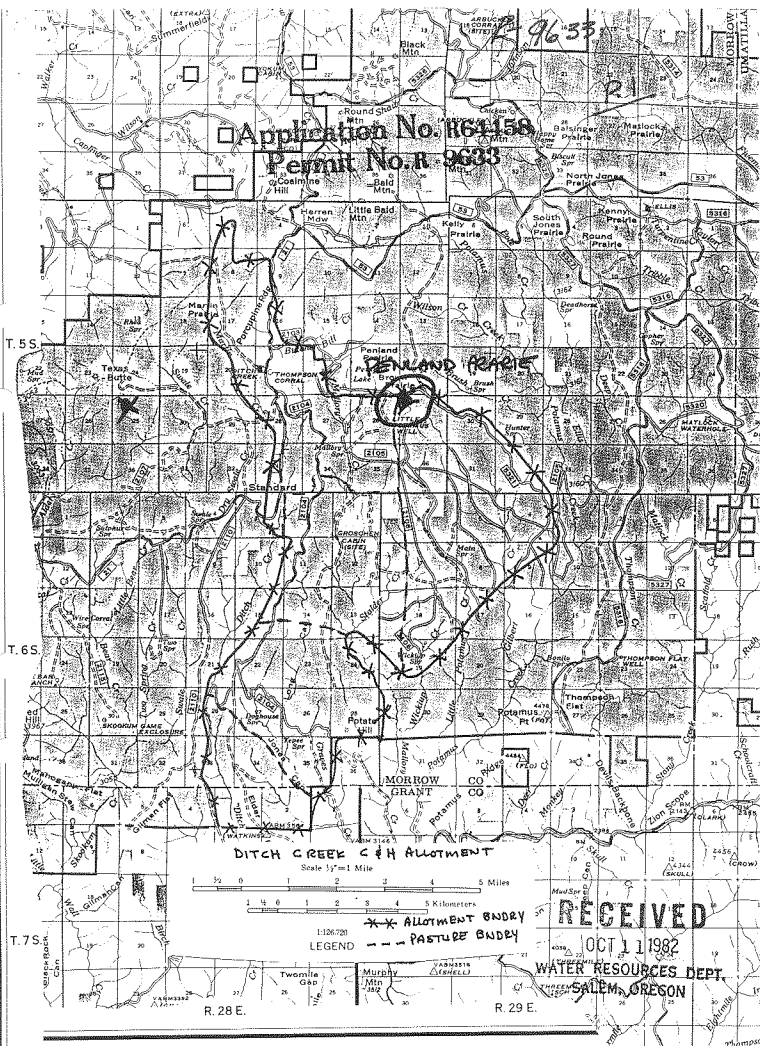

R-9633
P.2

Application No. R-6


ELKHORN

R20E