

R-9021

P. 3

RECEIVED

AUG 25 1983


WATER RESOURCES DEPT
SALEM, OREGON



Permit No. R 9021

R28E



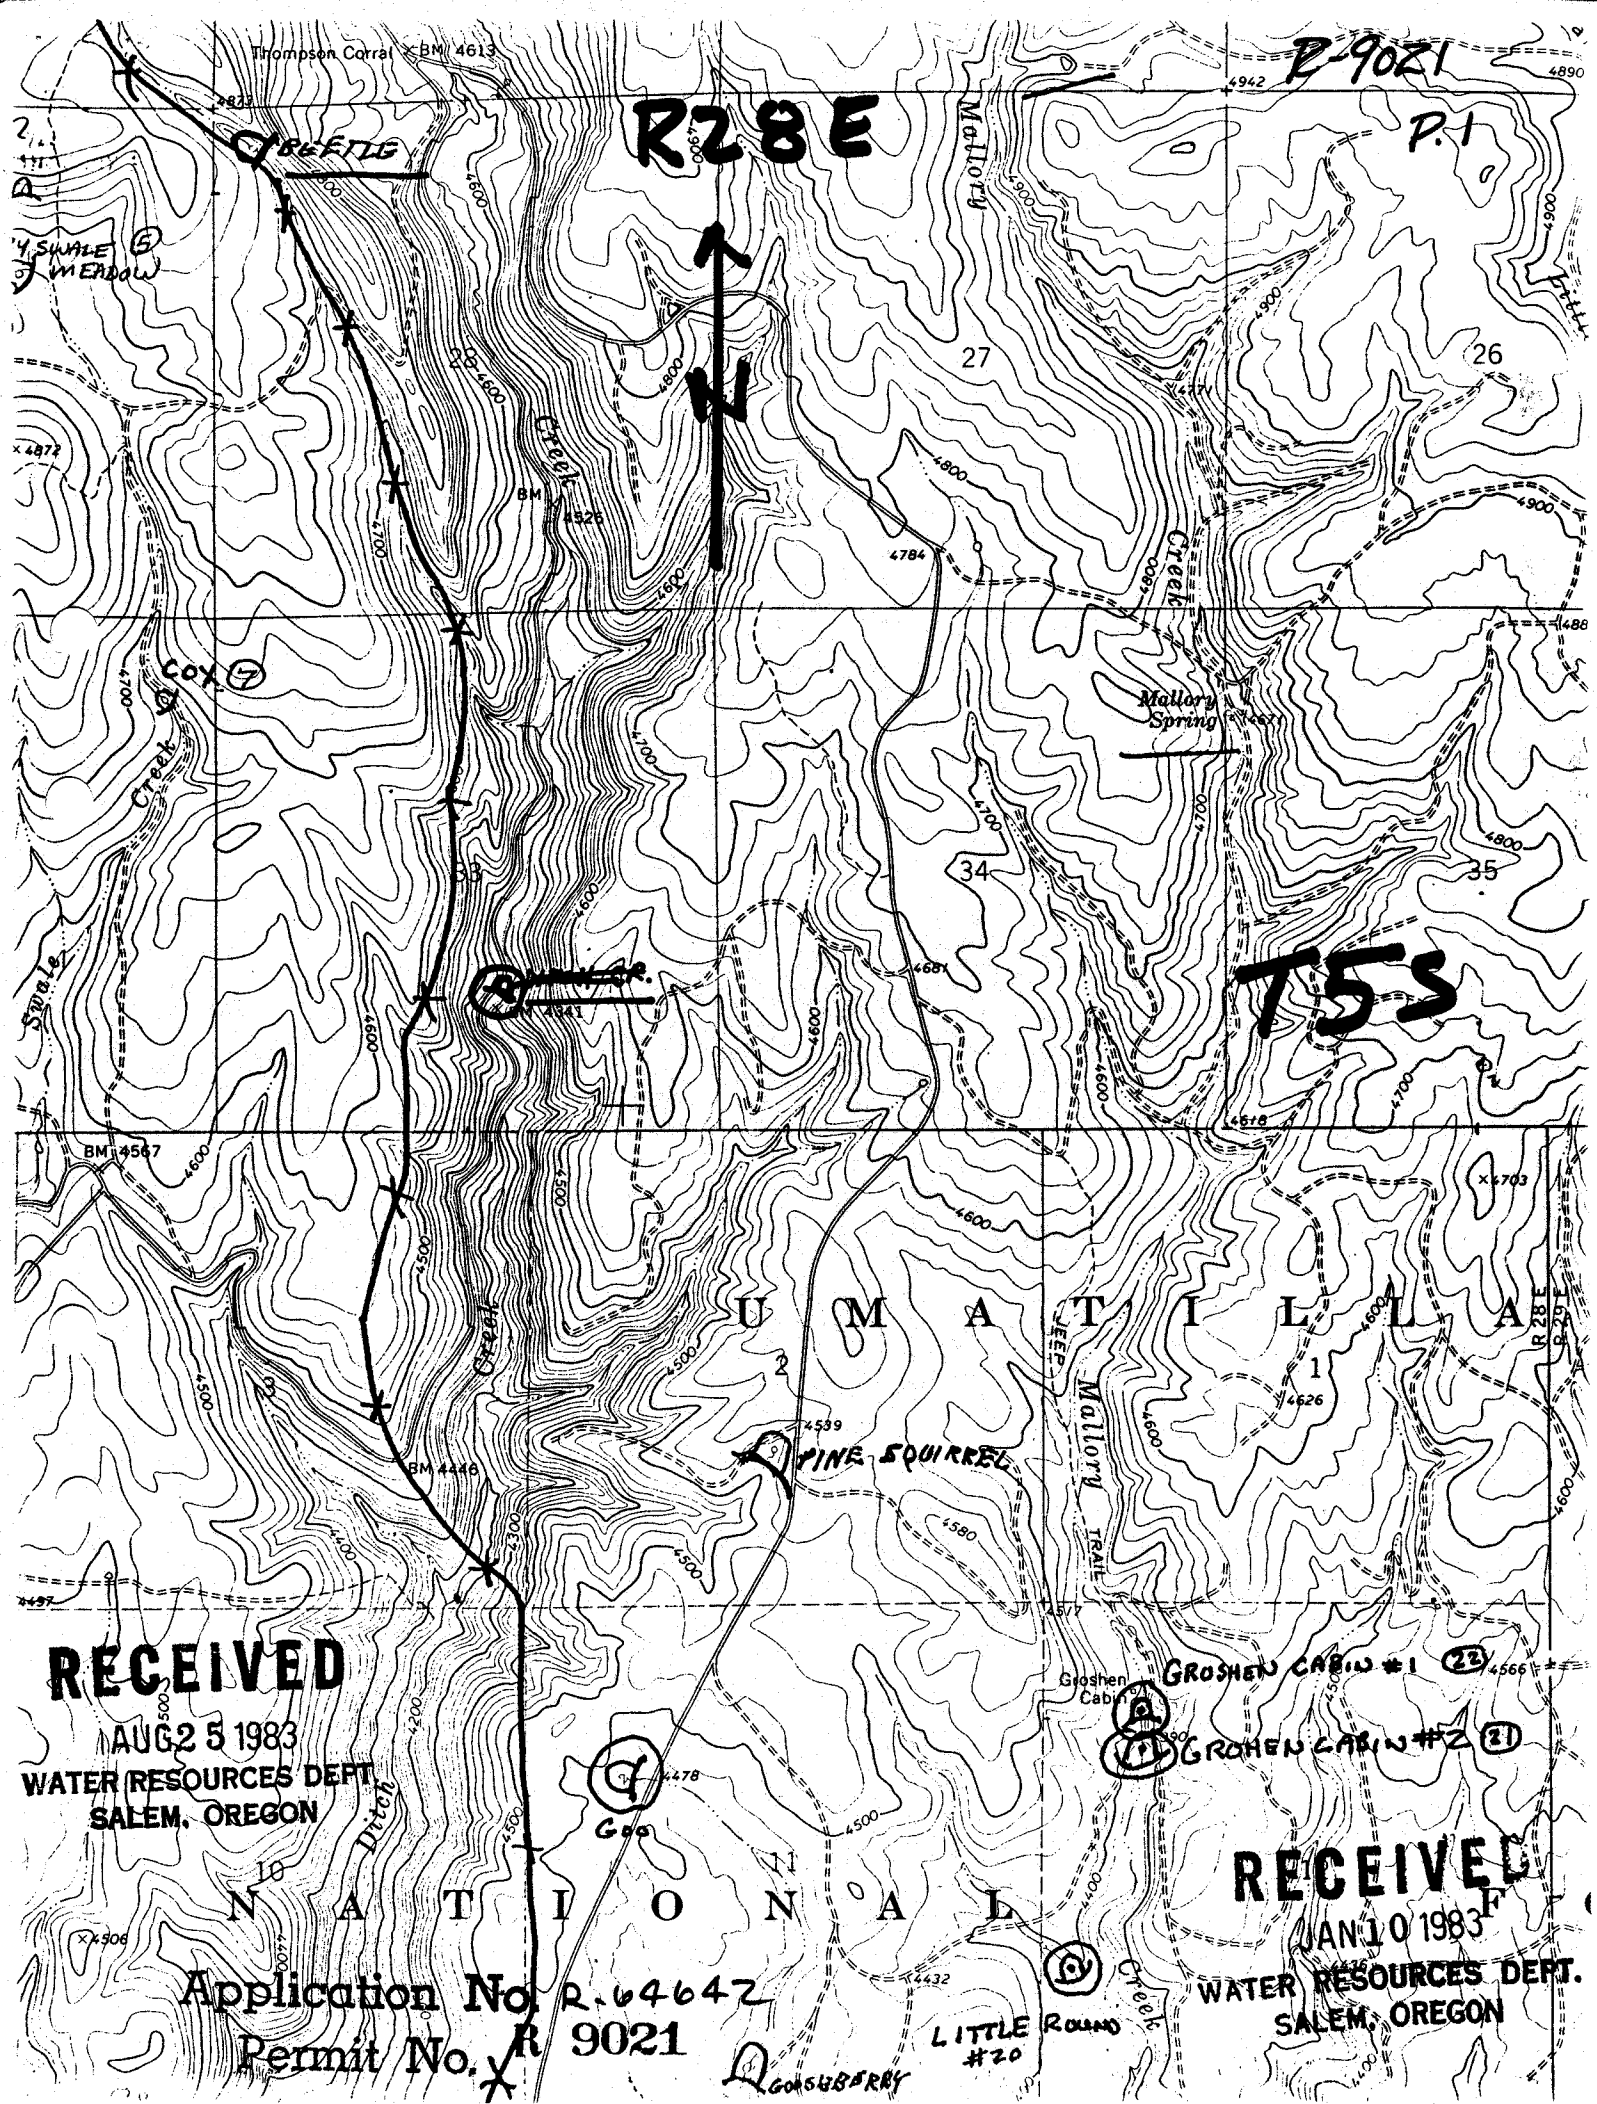

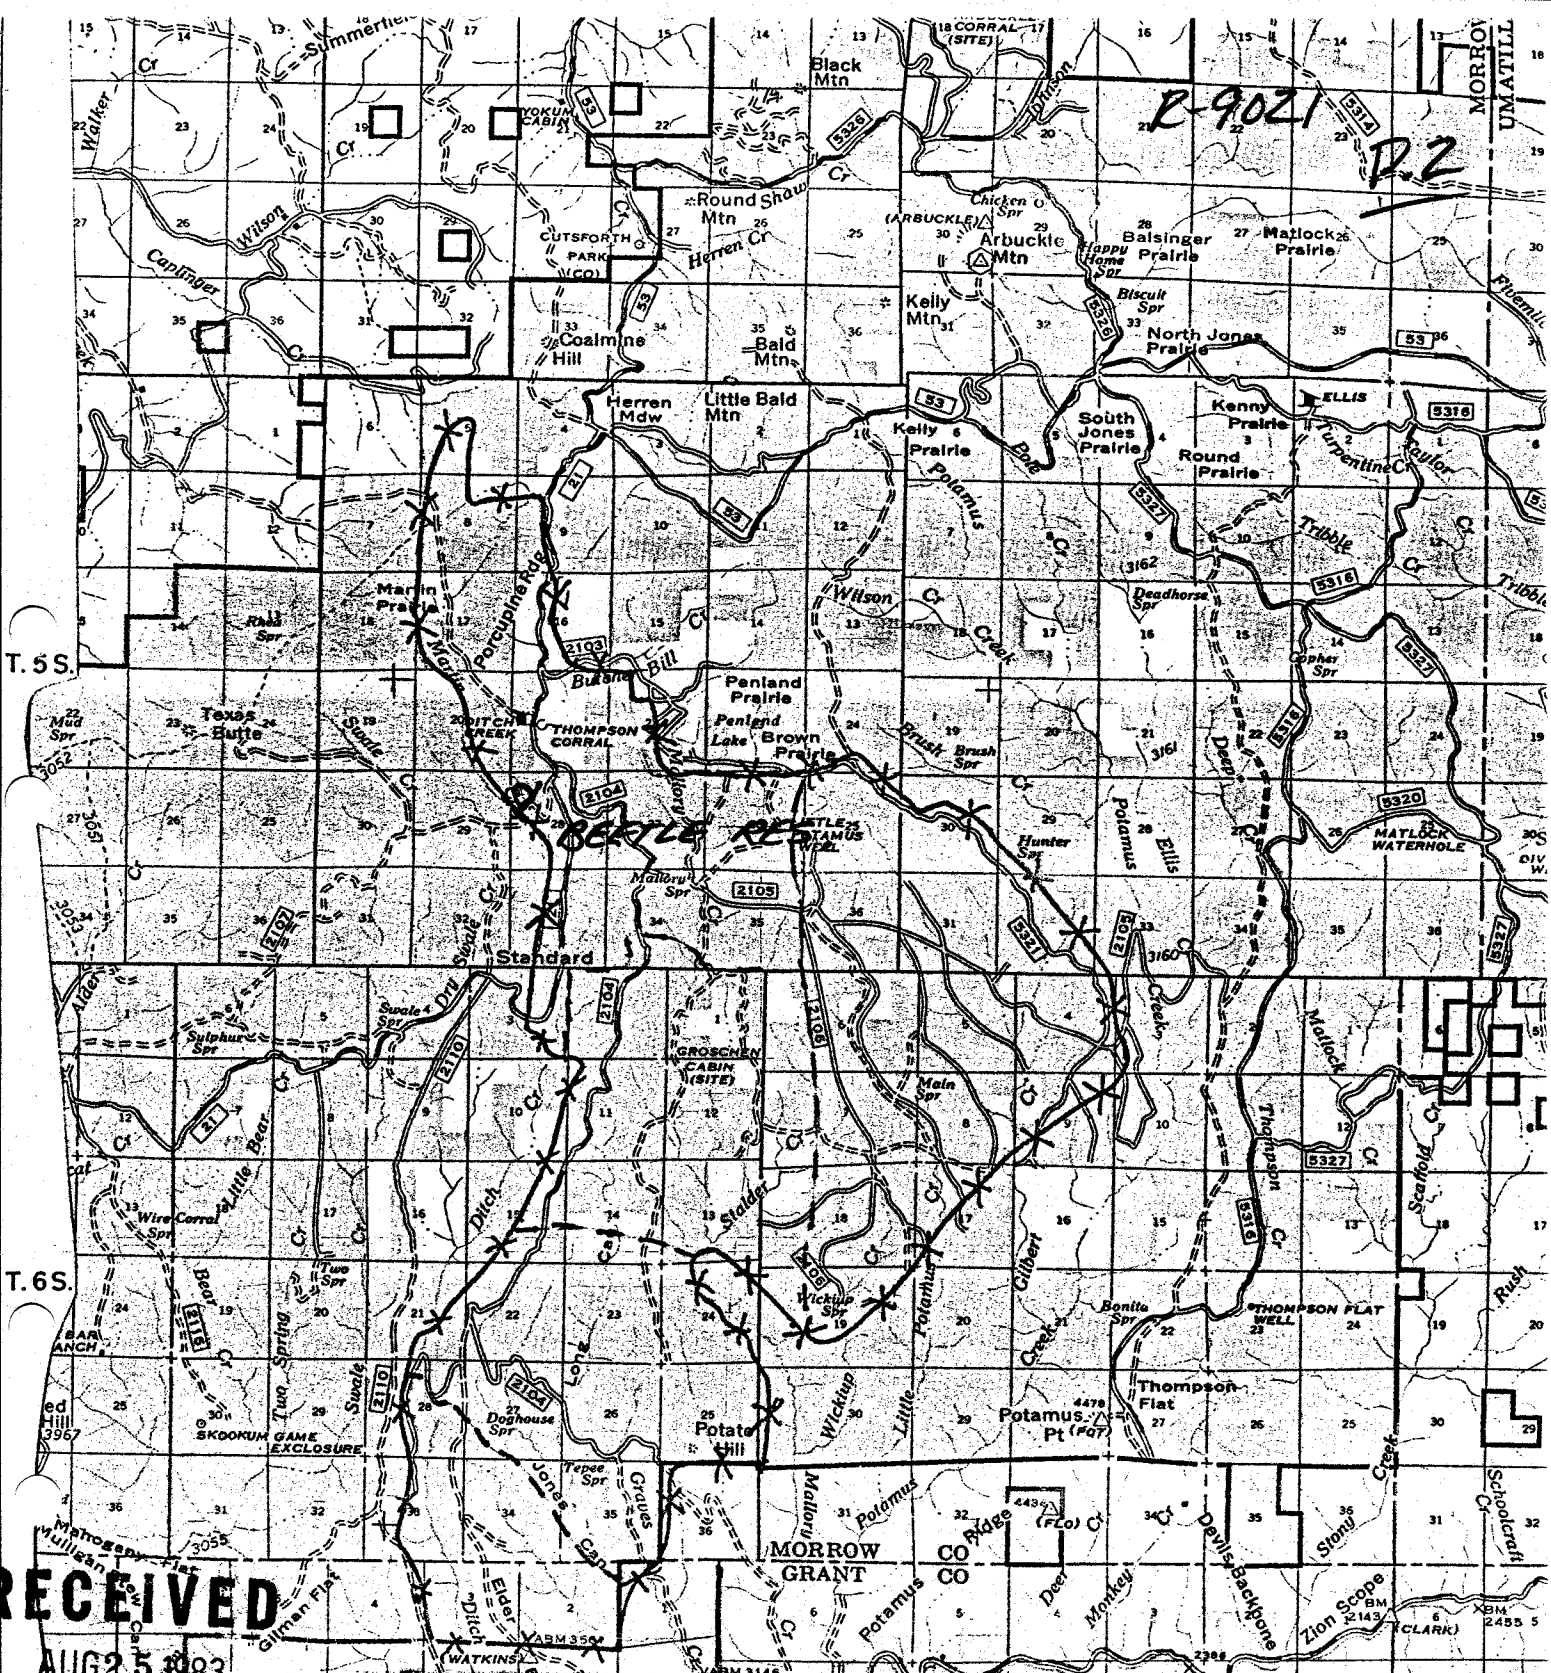

RECEIVED
 AUG 25 1983
 WATER RESOURCES DEPT.
 SALEM, OREGON

DITCH CREEK C & H ALLOTMENT

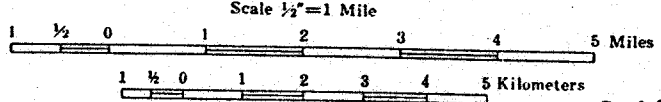

Application No. **R-64642**
 Permit No. **R 9021**

1:126,720
 LEGEND
 ** ALLOTMENT BNDRY
 --- PASTURE BNDRY

RECEIVED
 JAN 10 1983

WATER RESOURCES DEPT.
 SALEM, OREGON

R. 28 E.

R. 29 E.

Thompson