




RECEIVED

AUG 25 1983

WATER RESOURCES DEPT.
SALEM, OREGON

DITCH CREEK C & H ALLOTMENT

Scale 1/2" = 1 Mile

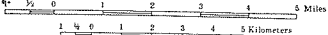

Application No. R-6643
Permit No. R 9022

Legend
 ** ALLOTMENT BNDRY
 --- PASTURE BNDRY

RECEIVED

JAN 10 1983

WATER RESOURCES DEPT.
SALEM, OREGON

R. 28 E.

R. 29 E.

MORRIS
UNATILE

R-9022
P.1


R-9022

P.2

RECEIVED

AUG 25 1983

WATER RESOURCES DEPT.
SALEM, OREGON

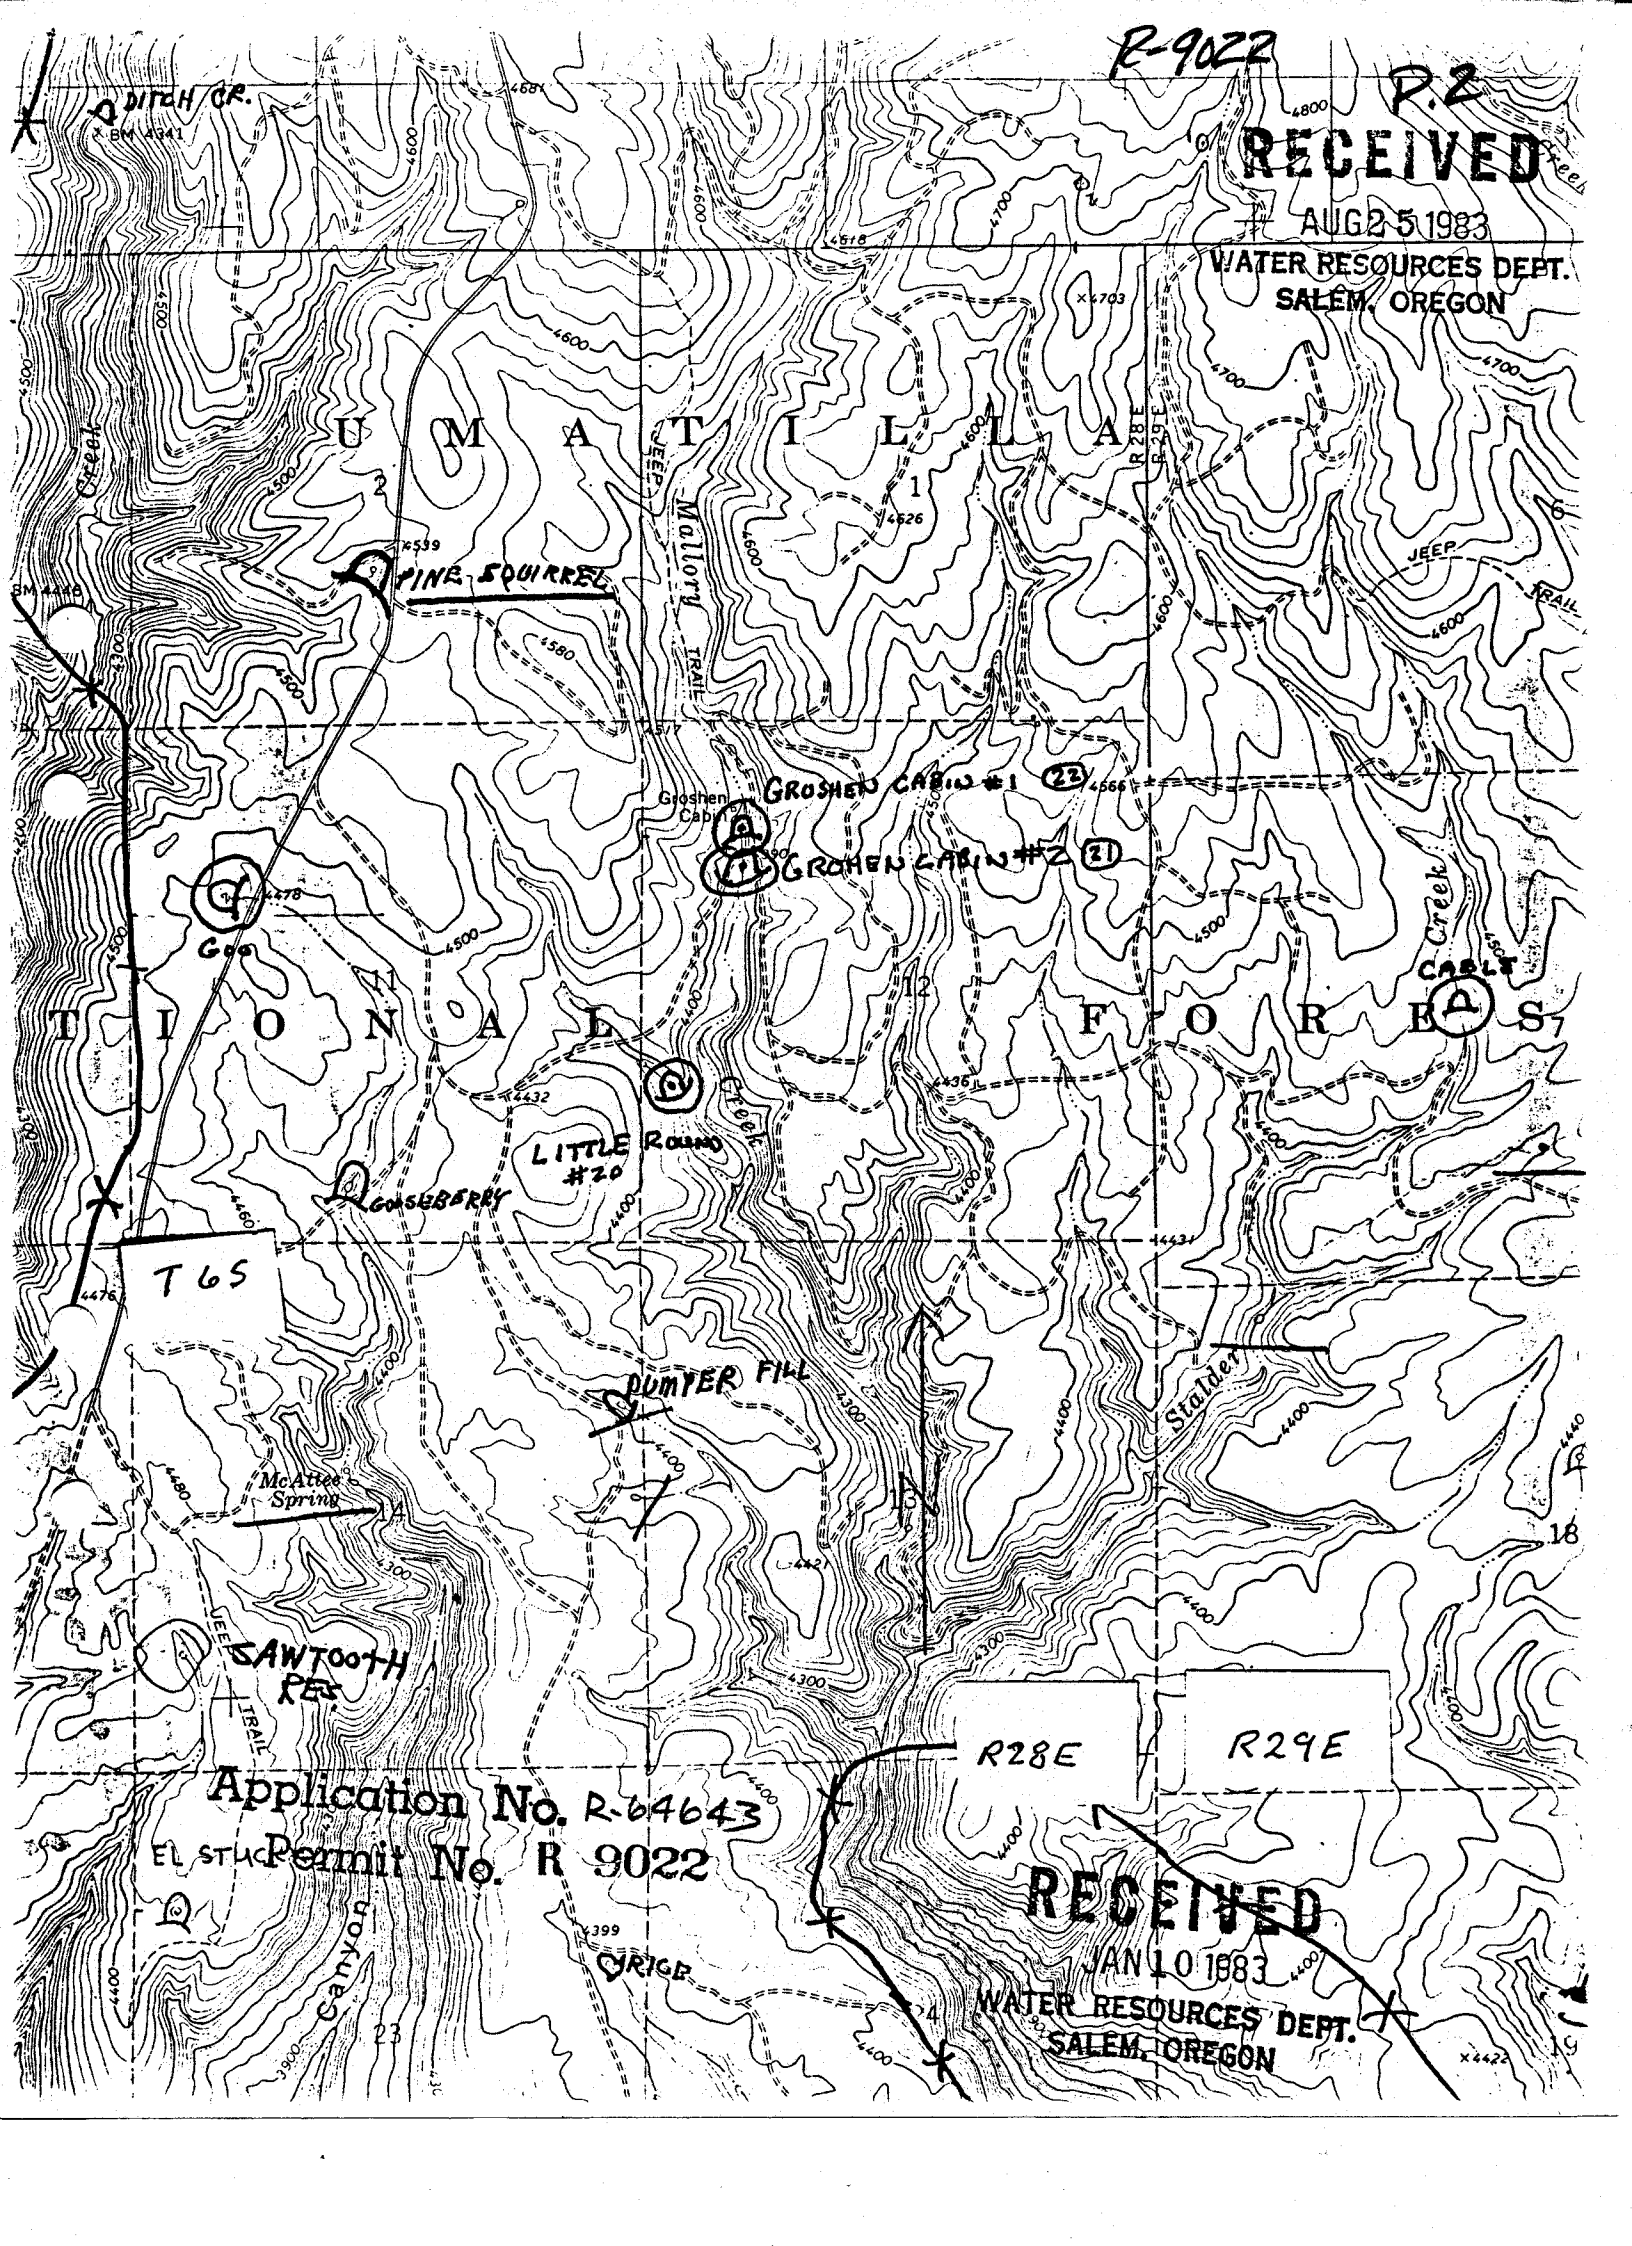

Application No. R-64643
EL STUCK Permit No. R 9022

RECEIVED

JAN 10 1983

WATER RESOURCES DEPT.
SALEM, OREGON