

R-7418

RECEIVED 67036
SEP 2 1983
WATER RESOURCES DEPT.
SALEM, OREGON

Form OR-010-7300-2
4/83


UNITED STATES
DEPARTMENT OF THE INTERIOR
BUREAU OF LAND MANAGEMENT

Section
7, 8, 17, 18

Township 40S.
Range 15E.
Will. Mer.

Appl. No. R-65842
Permit No. R 9418

Miller Creek & Misc.

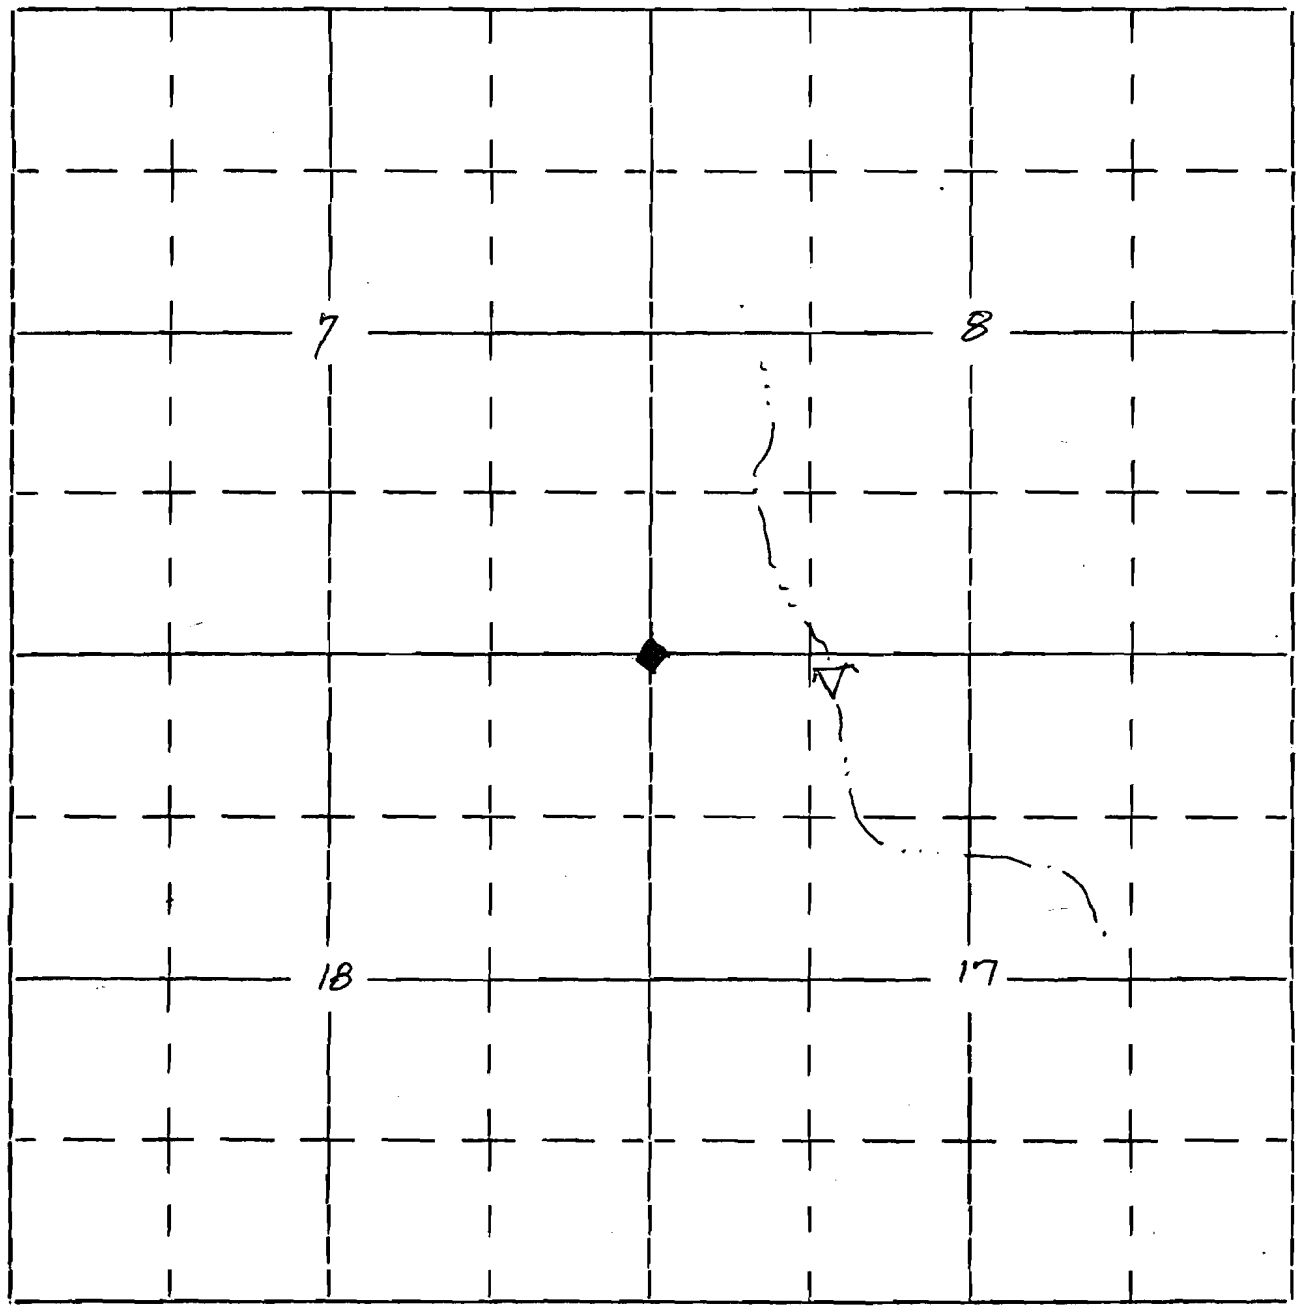

Project is located 1,760' east and 156' south of corner common
To sections 7, 8, 17, 18.