

R-9420
67037

RECEIVED

SEP 2 1983

LAND RESOURCES DEPT.
SALEM, OREGON

Form OR-010-7300-2
4/83

UNITED STATES
DEPARTMENT OF THE INTERIOR
BUREAU OF LAND MANAGEMENT

Section _____

Township 40 S.

Appl. No. R-65844


23, 24, 25 & 26

Range 14 E.

Permit No. R 9420

Will. Mer.

E. Branch Lost River & Misc.

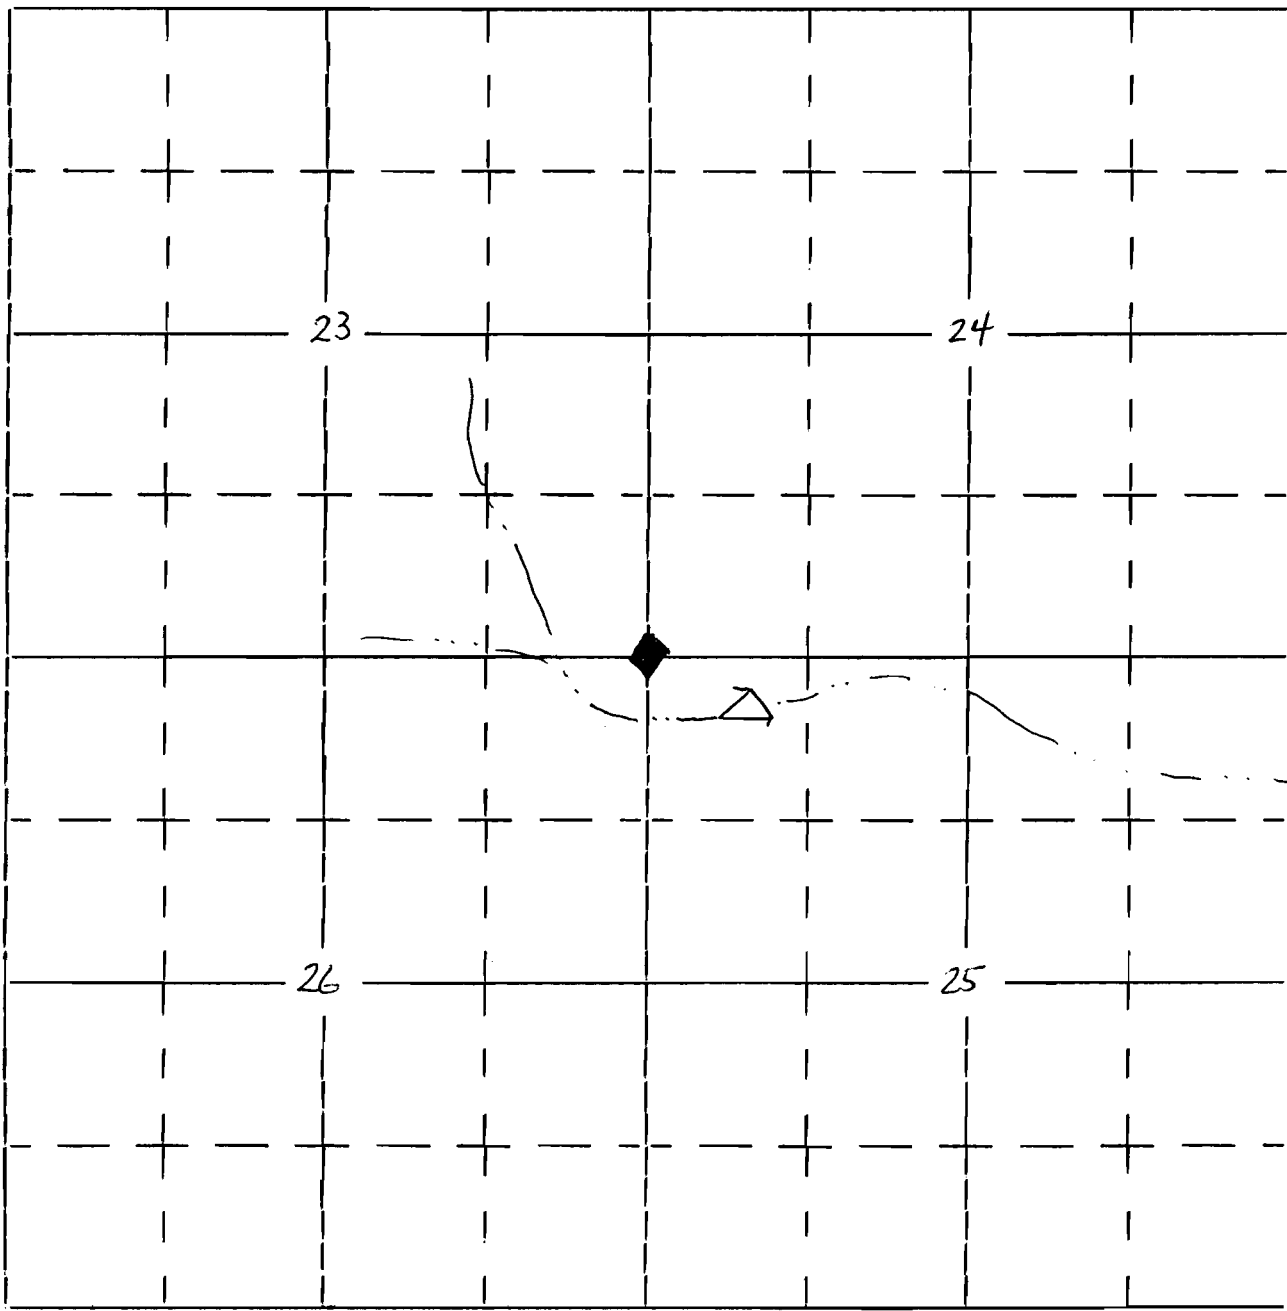

Project is located 578' East and 495' South of corner
common to sections 23, 24, 25 & 26.