


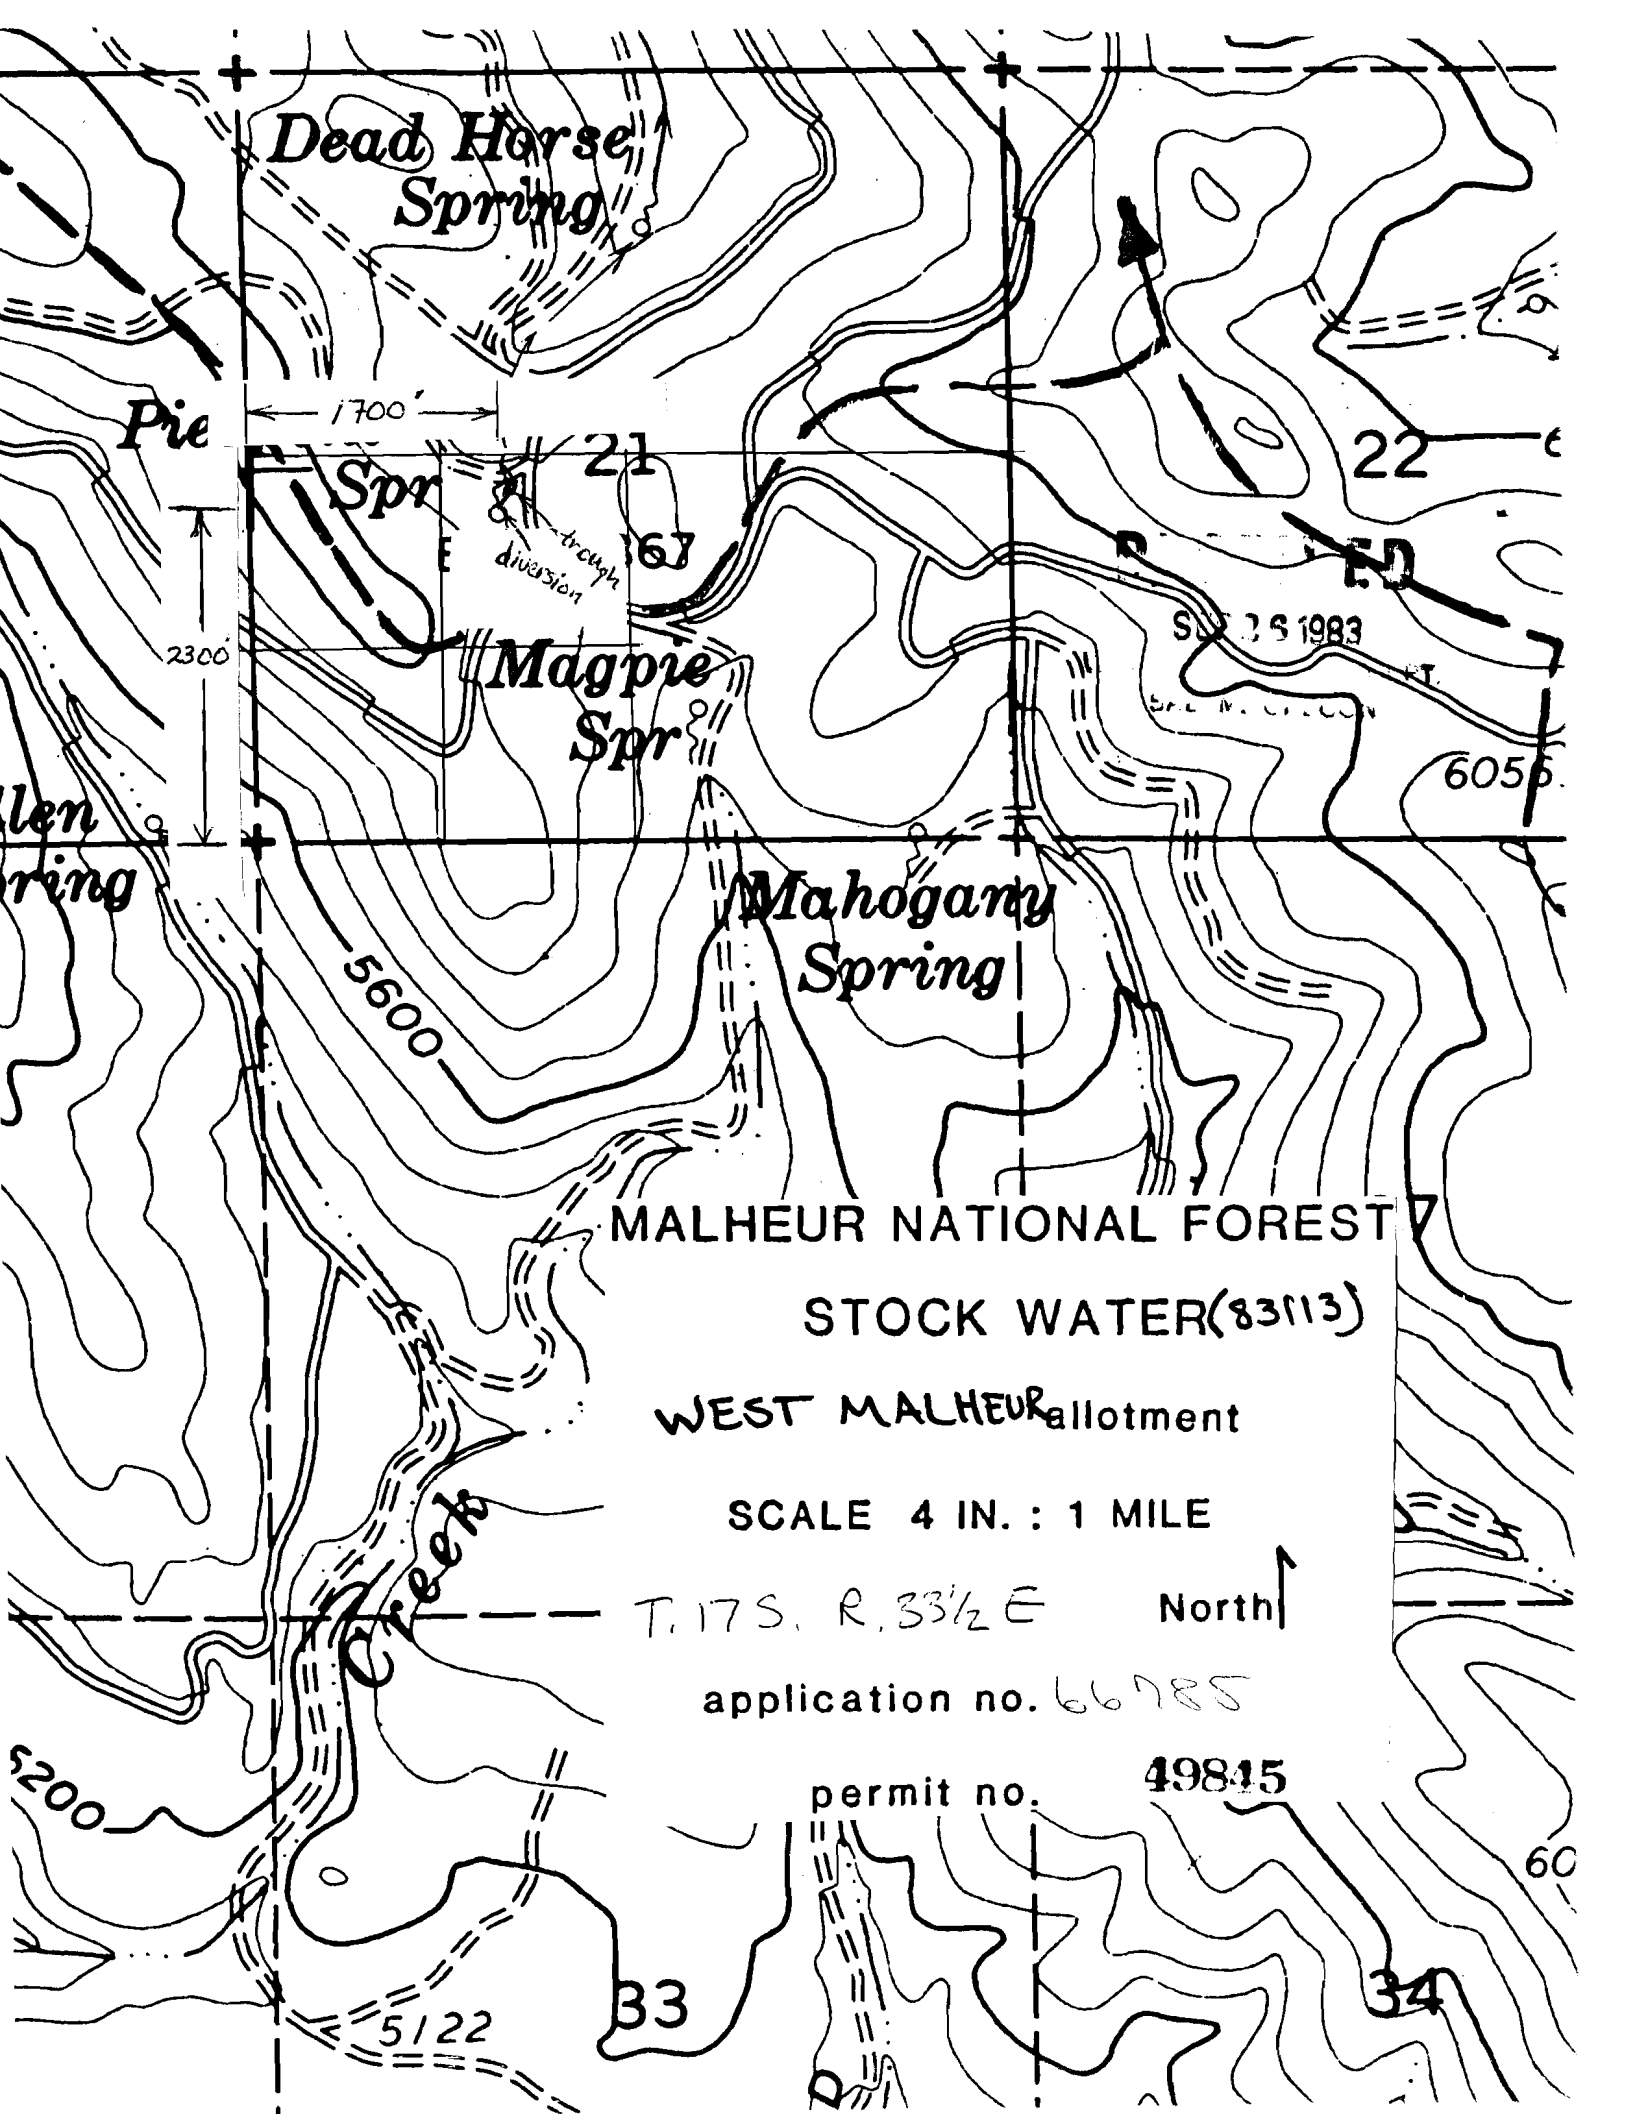

Dead Horse Spring

Pie

Spr

21

167

Maggie Spr

22

SEP 25 1983

6056

len
ring

Mahogany Spring

5600

MALHEUR NATIONAL FOREST

STOCK WATER(83113)

WEST MALHEUR allotment

SCALE 4 IN. : 1 MILE

T. 17 S. R. 33 1/2 E

North

application no. 66785

permit no.


5200

5122

33

34

60