


T. 9S., R. 14E., W.M.

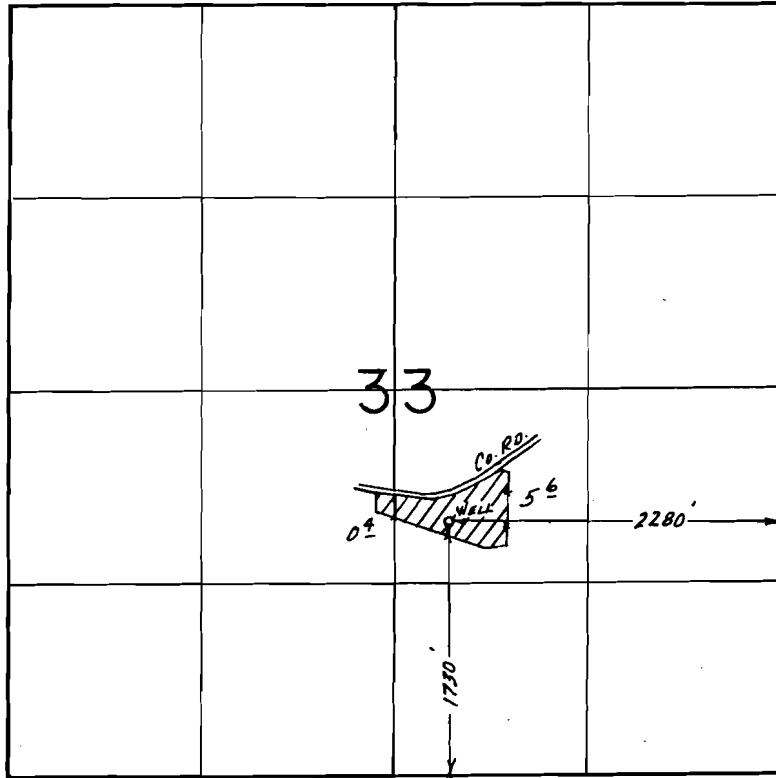

SCALE: 1" = 1320'

FINAL PROOF SURVEY
UNDER

Application No. G-7512.. Permit No. G-6989... Cert. 67060
IN NAME OF

..... LEROY C. FESSLER

Surveyed Mar. 20. 19.90, by ..R.W.. BISHOP....

Rec'd 2-13-92 WPA# 11

G-6989

1/28/91 BWB

41031-179-61C