


T. 2 N., R. 12 E., W.M.

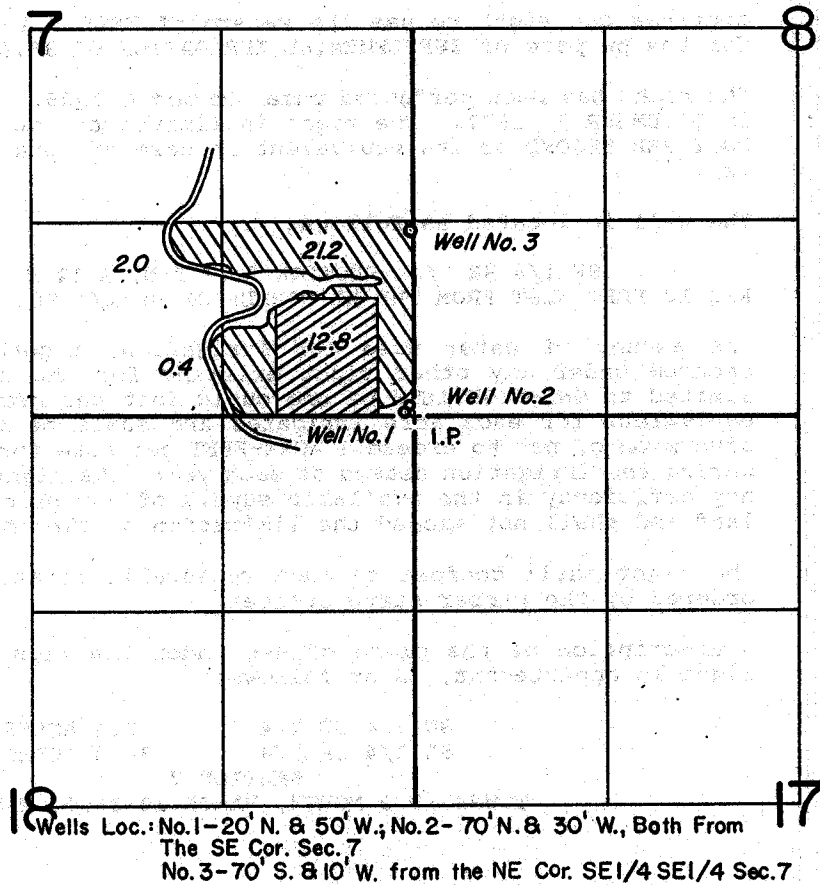

FINAL PROOF SURVEY UNDER

Application No. G-8560 Permit No. G-7905
G-5353 G-5249
G-8122 G-7499

IN NAME OF
BRUCE D. ECCLES

Surveyed MAR. 30, 1978, by L. NUNN
JULY 27, 1979 *L. Nunn*