

DAGGETT AVE.

FOOTHILL


PO

MOUNTAIN VIEW

CLAIRMONT DRIVE

Vacatedleton Drive

WILLIAM TUBACH - ASSES

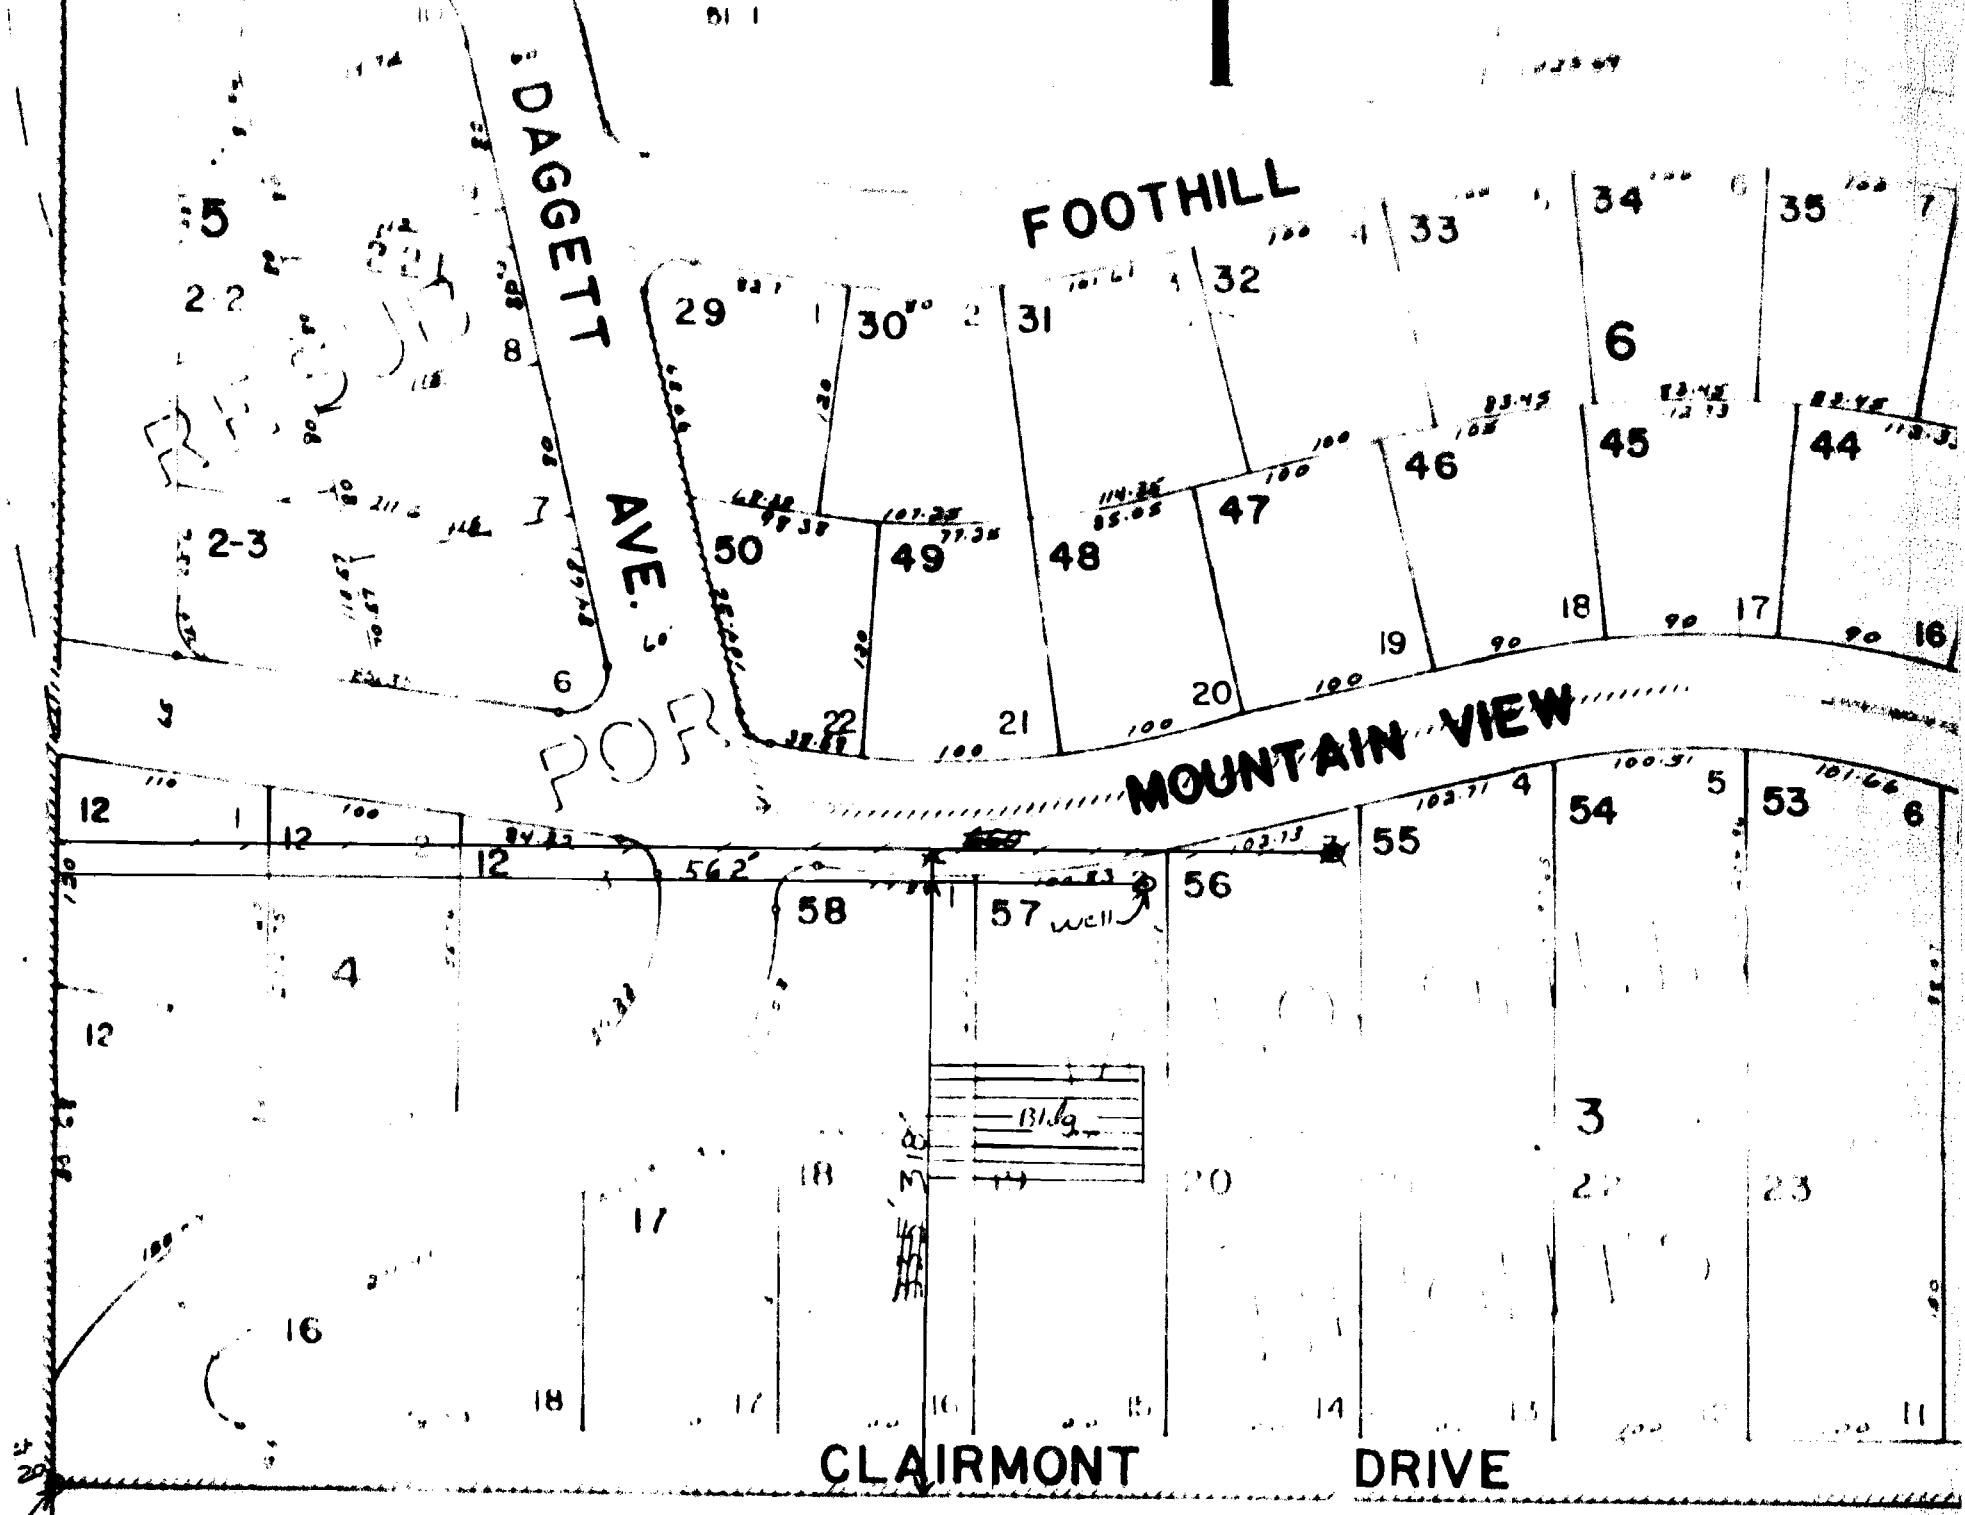

SW 1/4 NE 1/4 SEC. 2 T38S R9EWM

KLAMATH COUNTY

1" = 100'

Application No. G-10090
Permit No. G 9683

