


G-10657

C-67009

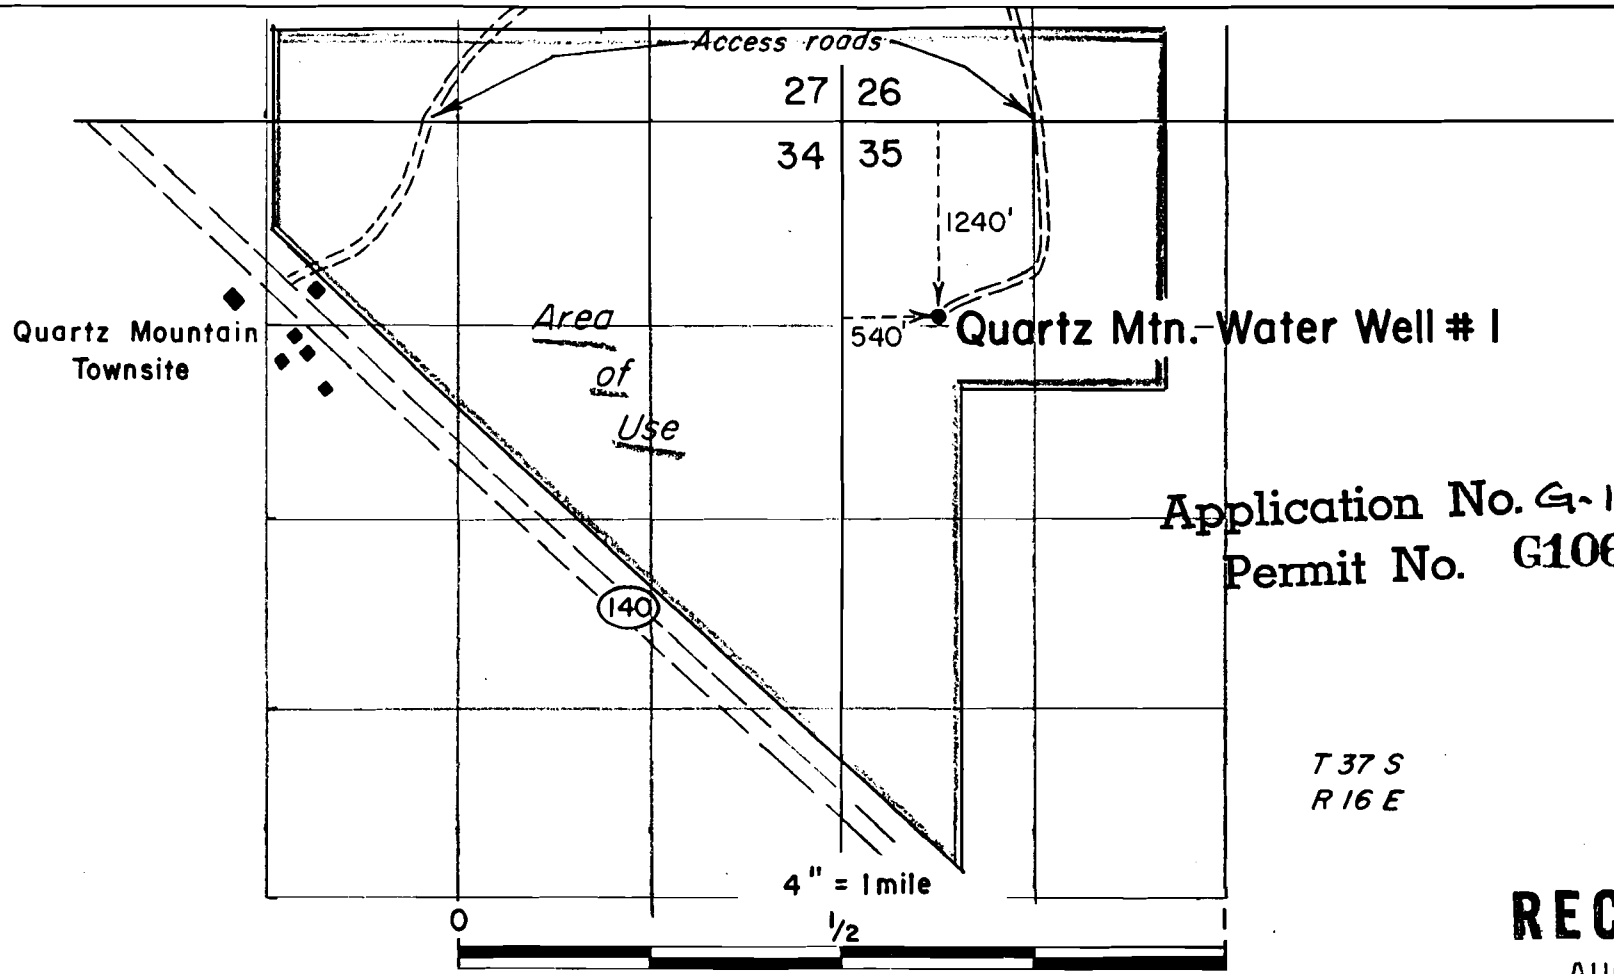

Application No. G-11559
Permit No. G10657

RECEIVED

AUG 18 1986

WATER RESOURCES DEPT
SALEM, OREGON

W.R. Rohtert
7/19/86

Location Map of the Quartz Mountain Water Well #1

QUARTZ MOUNTAIN PROJECT
LAKE COUNTY, OREGON