


T. 39 S., R. 8 W., W. M.

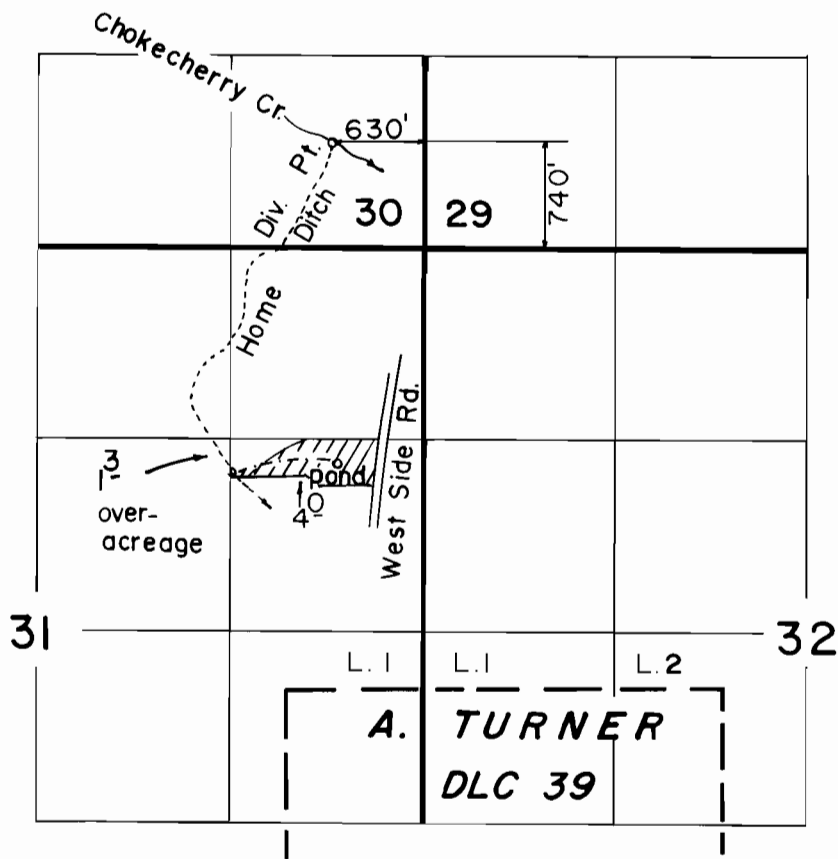

Scale: 1" = 1320'

FINAL PROOF SURVEY
UNDER

Application No. 44811 Permit No. 33516
IN NAME OF

JOE GONSALVES

Surveyed JUN. 9 1986, by B. S. JAMES.