
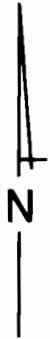


T. 28S., R. 14W., W.M.

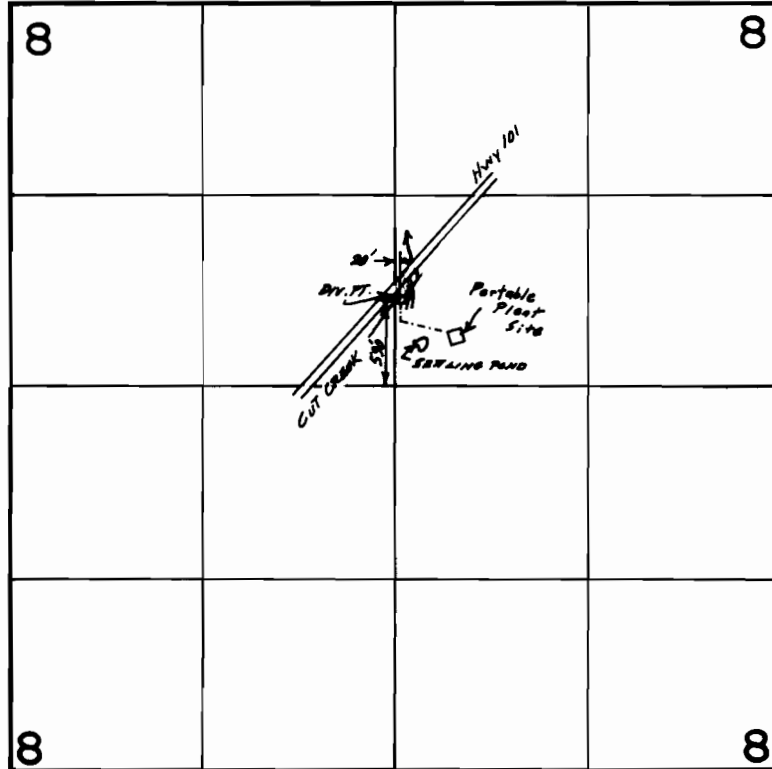

Scale 1" = 1320'

FINAL PROOF SURVEY UNDER

Application No. 50732 Permit No. 38316.....
IN NAME OF

BULLARDS SAND & GRAVEL.....

Surveyed Nov. 1..... 1983, by L. CASHION.....
Sept. 19, 1989, by S. JAMES