


T. 27S., R. 13W., W. M.

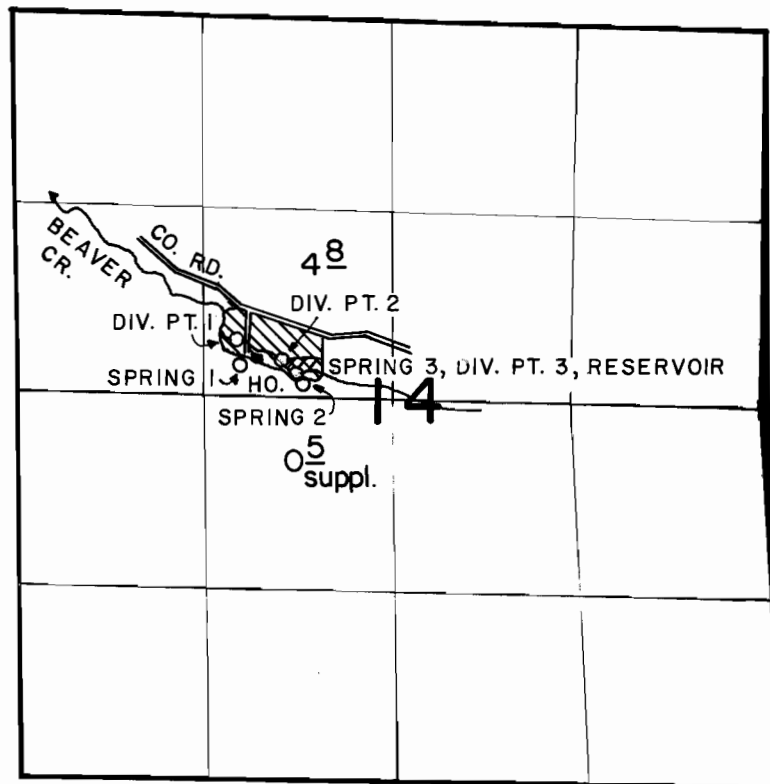

DIVERSION POINT 1 LOCATED 320' NORTH AND 1500' EAST FROM WEST 1/4 CORNER.
 DIVERSION POINT 2 LOCATED 160' NORTH AND 1800' EAST FROM WEST 1/4 CORNER.
 DIVERSION POINT 3 LOCATED 60' NORTH AND 1920' EAST FROM WEST 1/4 CORNER.
 SPRING 1 LOCATED 130' NORTH AND 1520' EAST FROM WEST 1/4 CORNER.
 SPRING 2 LOCATED 20' NORTH AND 1950' EAST FROM WEST 1/4 CORNER.
 SPRING 3 LOCATED 60' NORTH AND 1920' EAST FROM WEST 1/4 CORNER.

SCALE: 4" = 1 MILE

FINAL PROOF SURVEY

UNDER

R-53150 R-6226
 Application No. 53151 Permit No. 38813
 IN NAME OF

RUTH E. AND V.E. SANDERSON

Surveyed OCT. 18 1983, by L. E. CASHION