


# T. 33 S., R. 3 E., W.M.

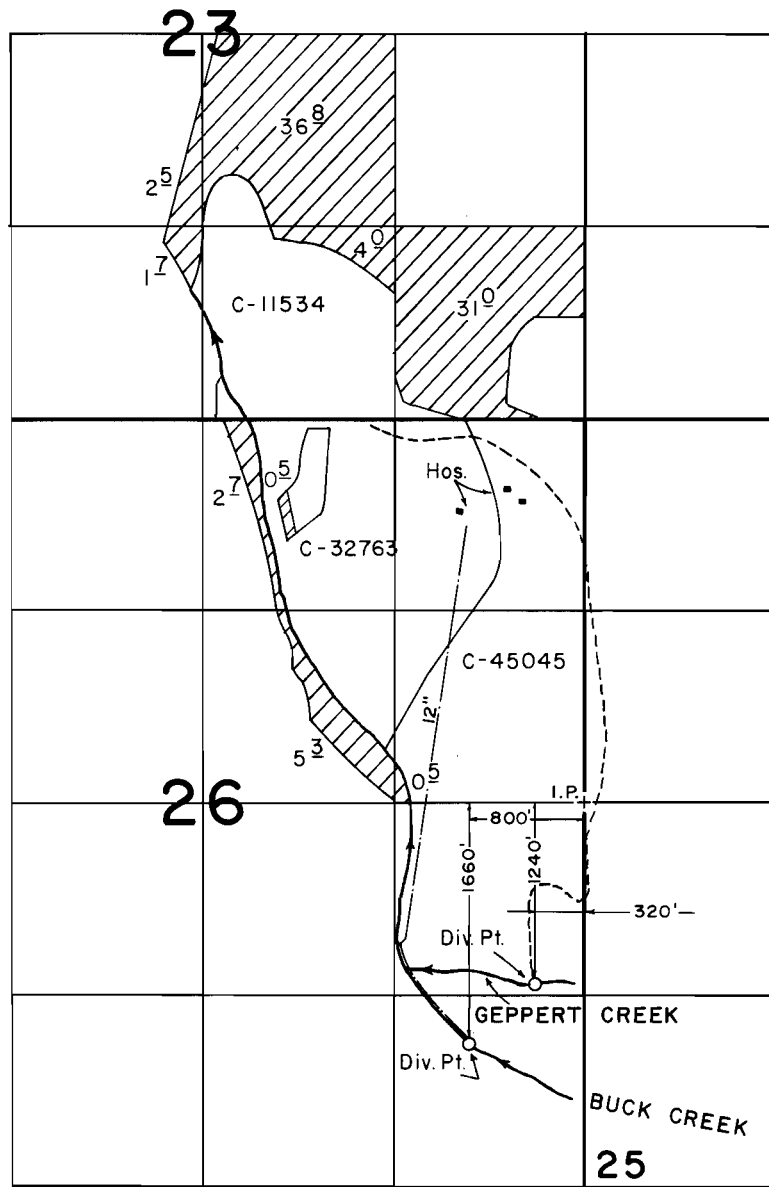

SCALE: 1" = 1320'

## FINAL PROOF SURVEY UNDER

Application No. 55000.. Permit No. 41213.....  
IN NAME OF

M. H. & /OR JULIA M. PINGLE.

Surveyed JUNE 21, 1989, by B. S. JAMES.....