


T.8 S., R. 38E., W. M.

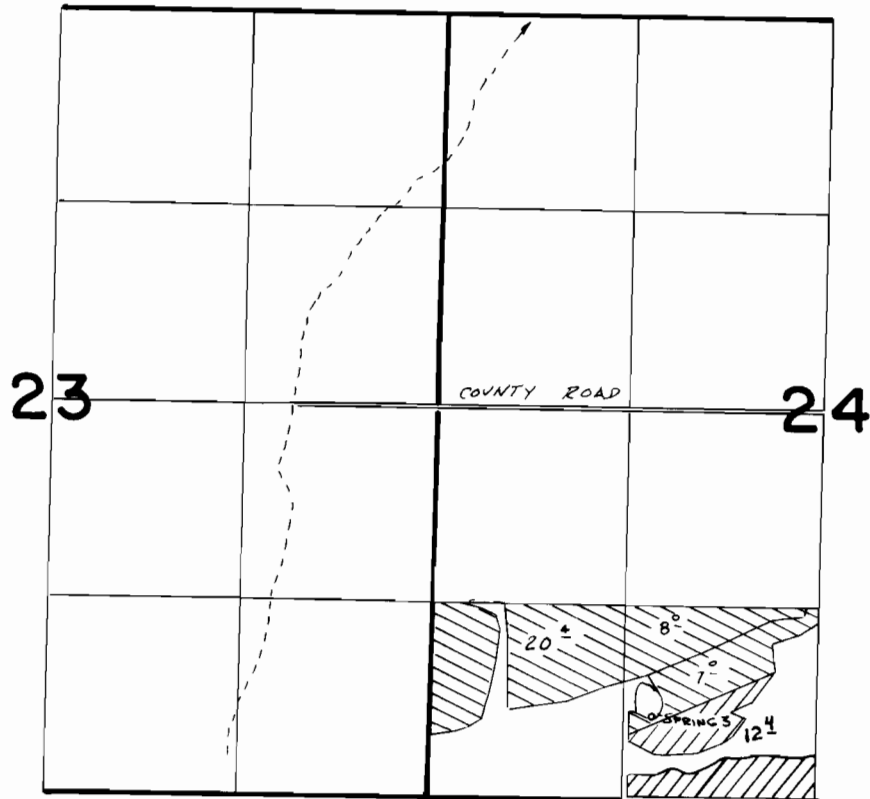

SPRING 3-570' N. & 1510' E From SW COR. SEC. 24



SUPPLEMENTAL



PRIMARY

FINAL PROOF SURVEY
UNDER

Application No. **55158** Permit No. **41459**
IN NAME OF

HARRY A. PHILLIPS

Surveyed JULY 16 1987, by V.R. Church
APRIL 15 1987