


T.18S., R.1W. WM.

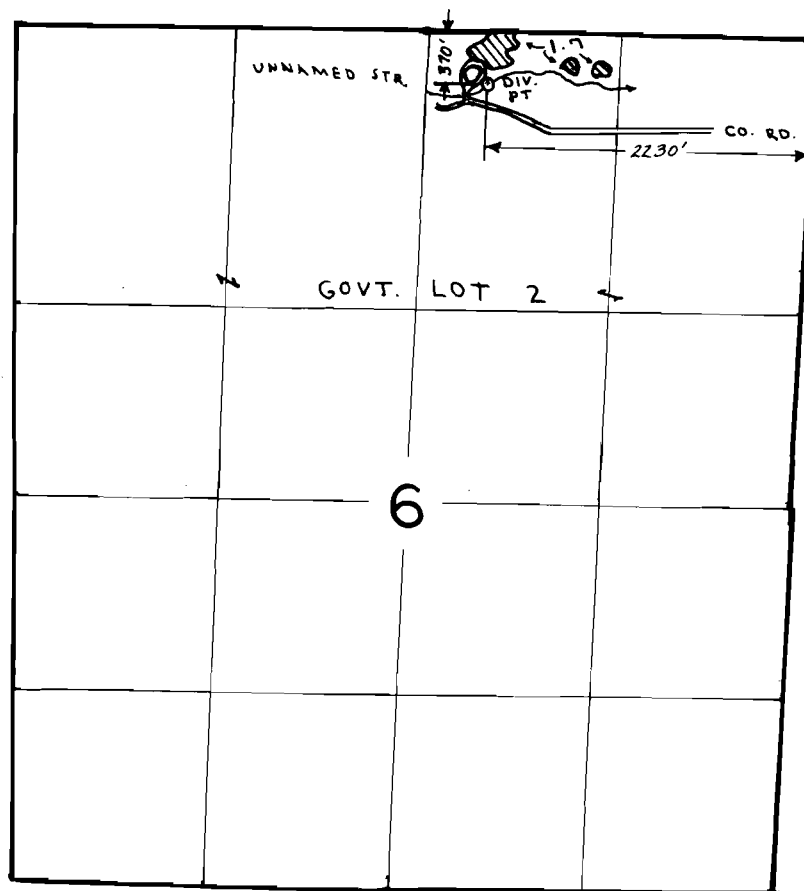

FINAL PROOF SURVEY
UNDER

Application No. 56376 Permit No. 42307

IN NAME OF

CHARLES A. EDWARDS

Surveyed NOV. 15, 1983, by P. PAGTER