


T.1N., R.39E., W.M.

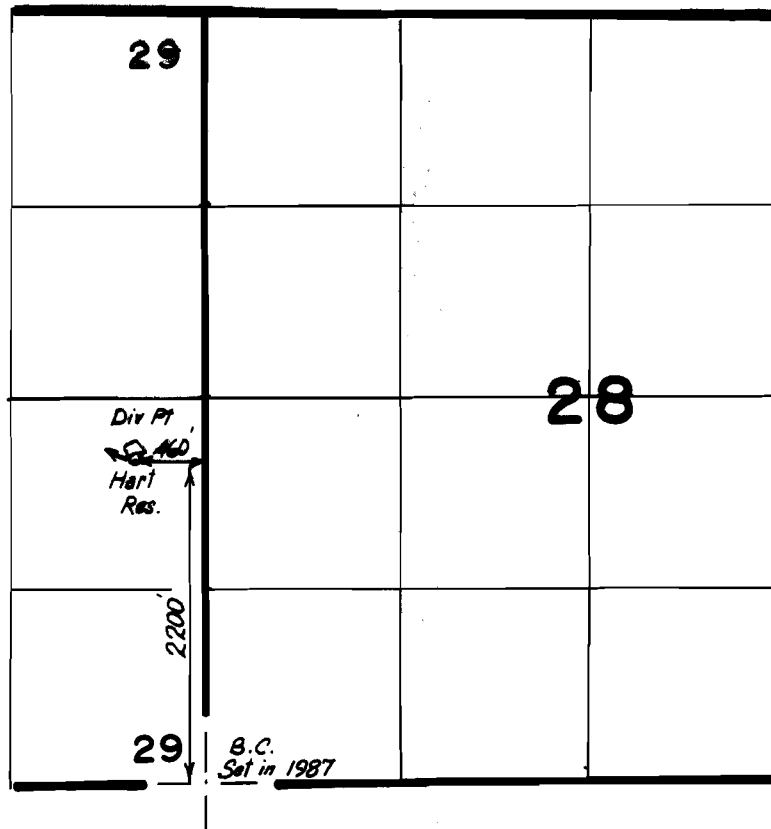

FINAL PROOF SURVEY
UNDER


Scale: 1" = 1320'

Application No. R56944 Permit No. R6894.....
IN NAME OF

ERNEST J. KIRCH & RALPH D. HART

Surveyed 4-11..... 1988., by Vern. Church....

T.1N., R.39E., W.M.

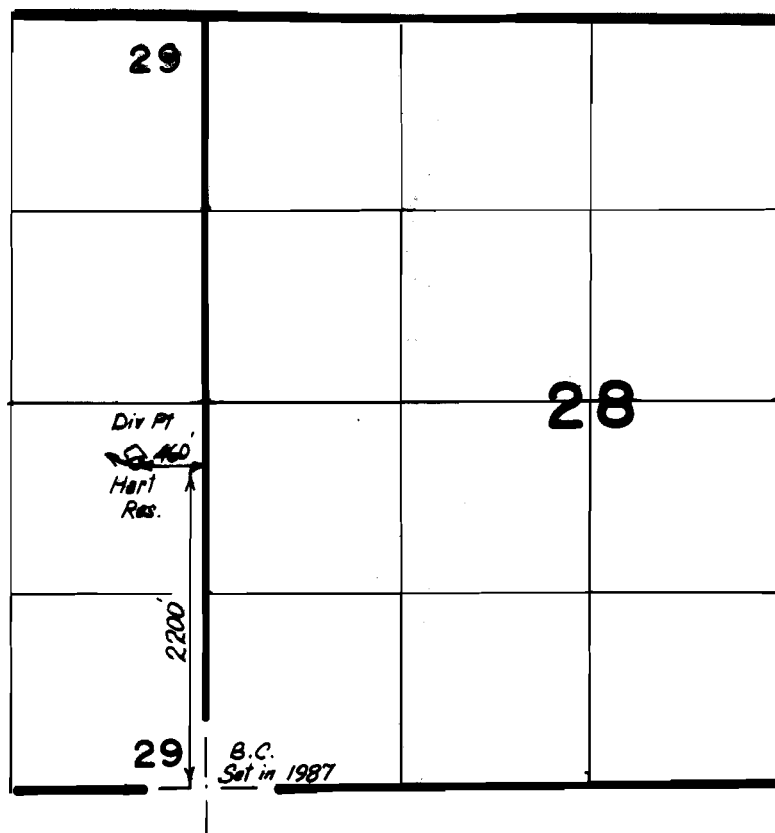

FINAL PROOF SURVEY
UNDER

Scale: 1" = 1320'

Application No. R56944 Permit No. R.6894.....
IN NAME OF

ERNEST J. KIRCH & RALPH D. HART

Surveyed 4-11..... 1988., by Vern. Church....