


T.11S., R.40E., W.M.

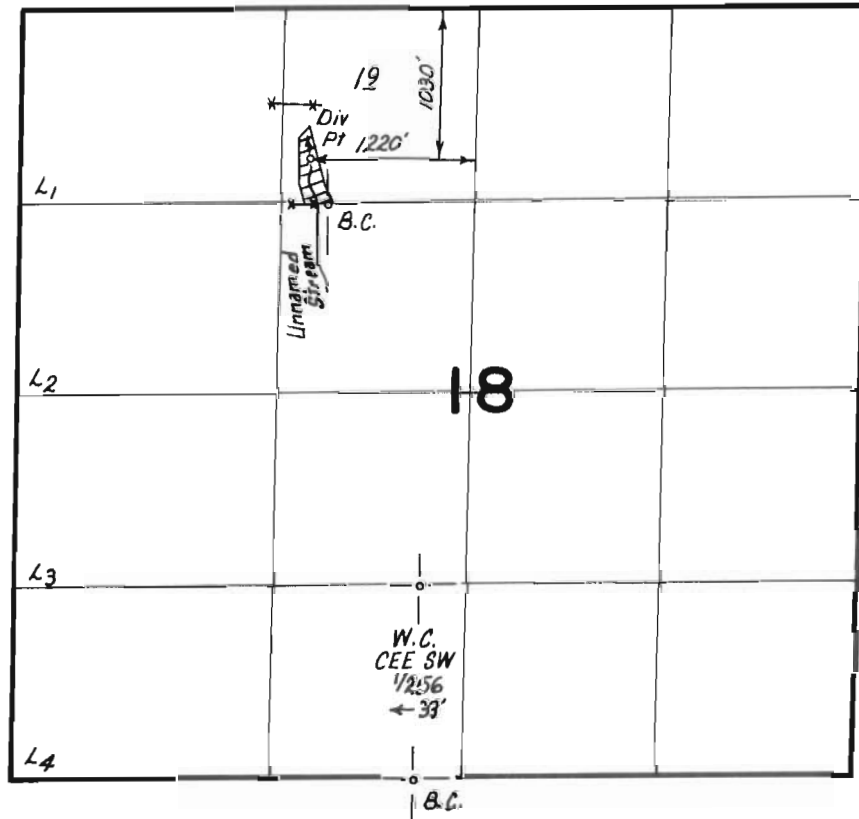

FINAL PROOF SURVEY

UNDER

Scale: 1" = 1320'

Application No. 57042 Permit No. 42938
IN NAME OF

LEROY JAMES HERMEN

Surveyed 9-29 1988, by Kenn Kemp

PTS 4/87 KK