


T. 30 S., R. 14 W., W. M.

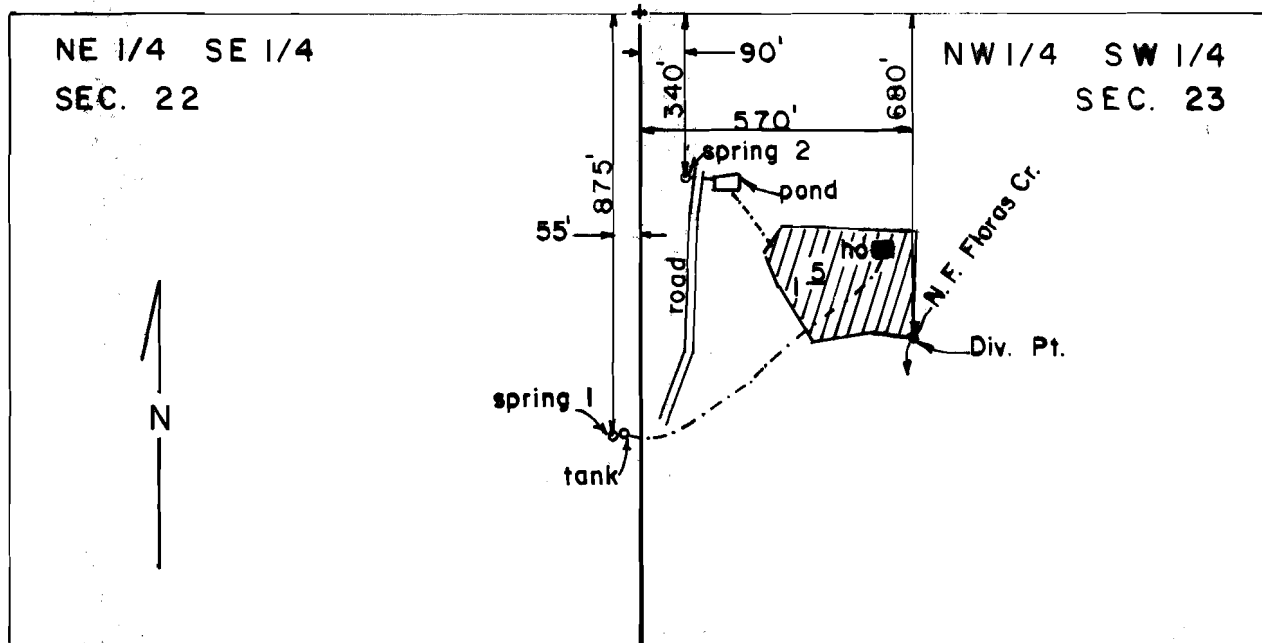

Scale: 1" = 400'

FINAL PROOF SURVEY UNDER

Application No. 57061... Permit No. 42968...
IN NAME OF

PAUL E. K. SMELTZER

Surveyed JUN. 24. 1988, by B. S. JAMES...