


T. 38 S., R. 8 W., W. M.

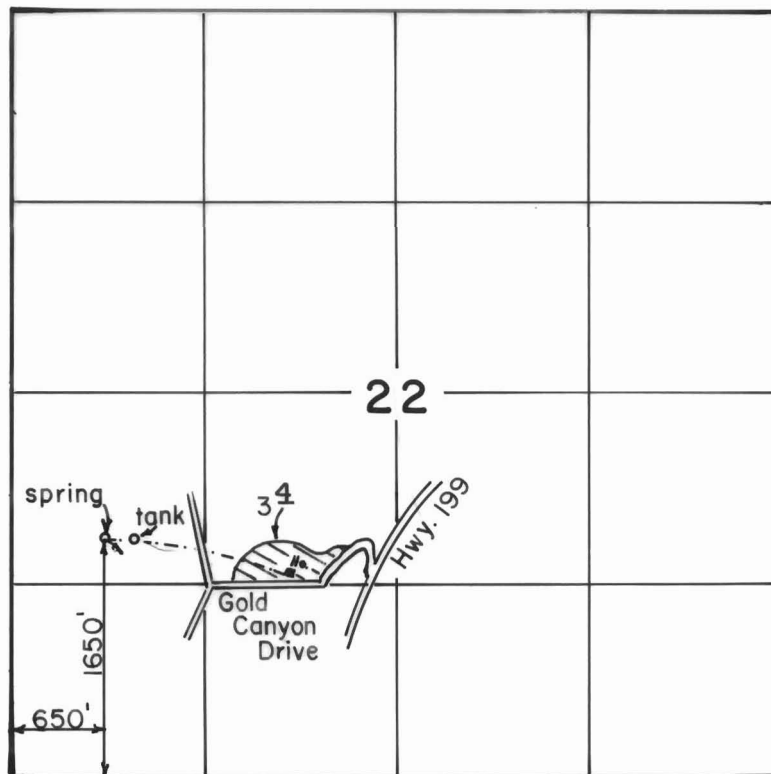

Scale: 1" = 1320'

**FINAL PROOF SURVEY
UNDER**

Application No. ~~57590~~ Permit No. ~~44123...~~
IN NAME OF

.....~~ALLEN~~.....~~BERSAGLIERI~~.....

Surveyed ~~MAY.23~~ 19~~88~~, by ~~B...~~S...JAMES...