


T.10S., R.4W., W.M.

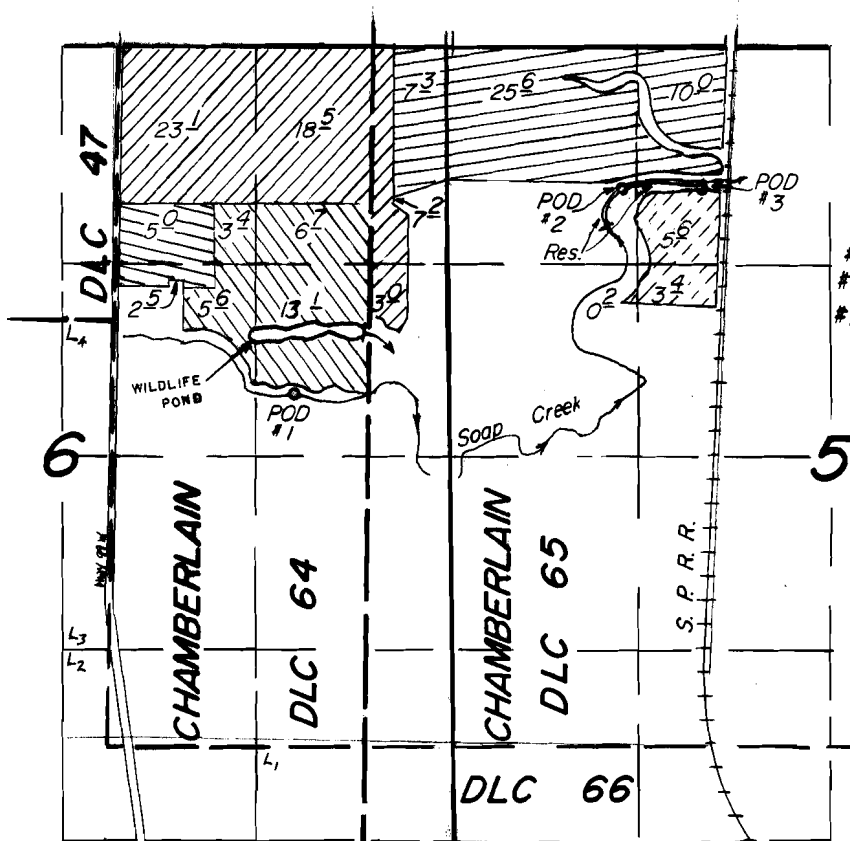

POD Locations:
 #1: 420' N., 1050' W.
 #2: 1840' N., 1220' E.
 #3: 1840' N., 1760' E.

All from E. 1/4 Cor.
 Sec. 6.
 T.10S., R.4W., W.M.

Scale: 1" = 1320'

FINAL PROOF SURVEY

UNDER

R-57851 R-7823
 57852 44137
 59831 44956

Application No. 61441..... Permit No. 45738.....

IN NAME OF

GEORGE W. GORDON

Surveyed Sept. 6, 1984, by Pete Pagter.....

