


T. 18 S., R. 10 E., W. M.
SEC. 10
NW 1/4 NE 1/4

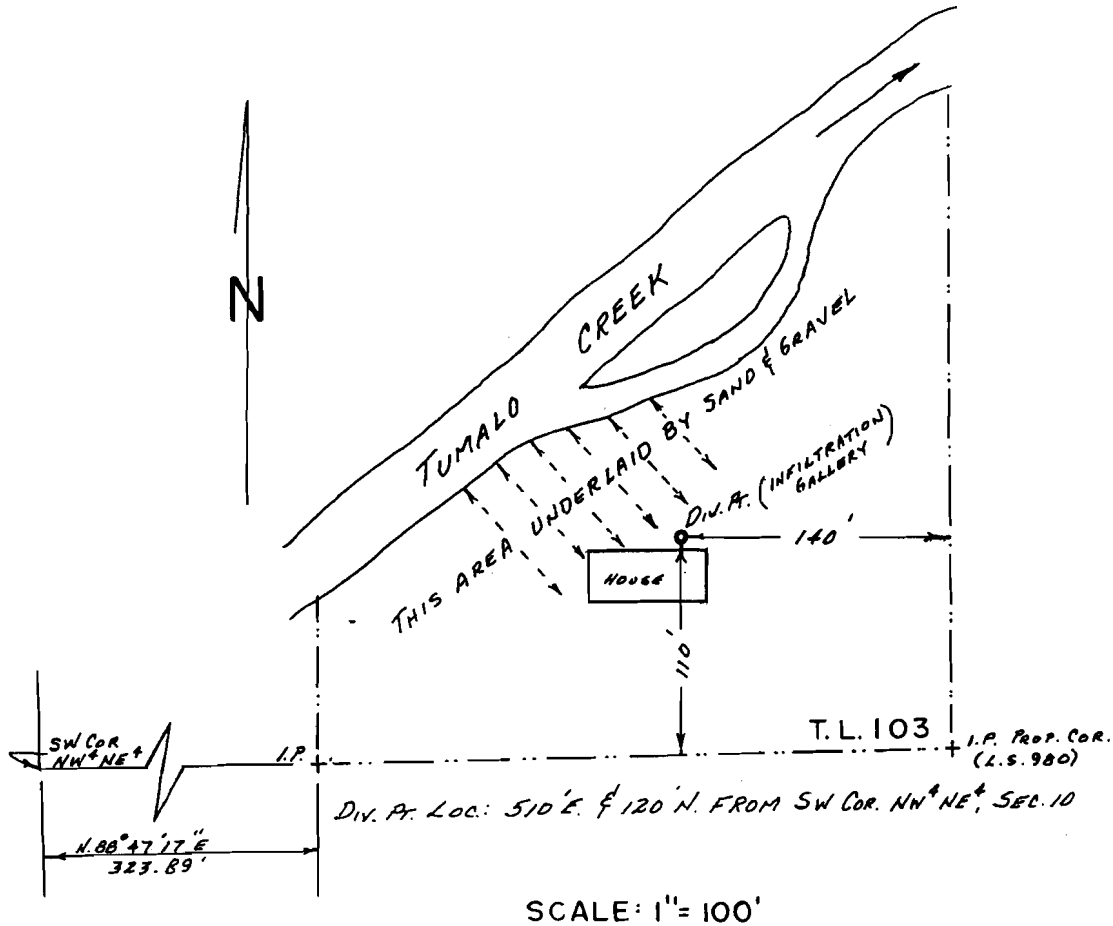

FINAL PROOF SURVEY
UNDER

Application No. 63057. Permit No. 46651.....
IN NAME OF

TOM CLEMMONS

Surveyed May 19 1989, by B.W. BISHOP.....

Cert. 67091

Rec'd 3-12-92

1-10-91
CHAIN SURVEY *AB*

46651