


T. 28 & 29 S., R. 12 W., W.M.

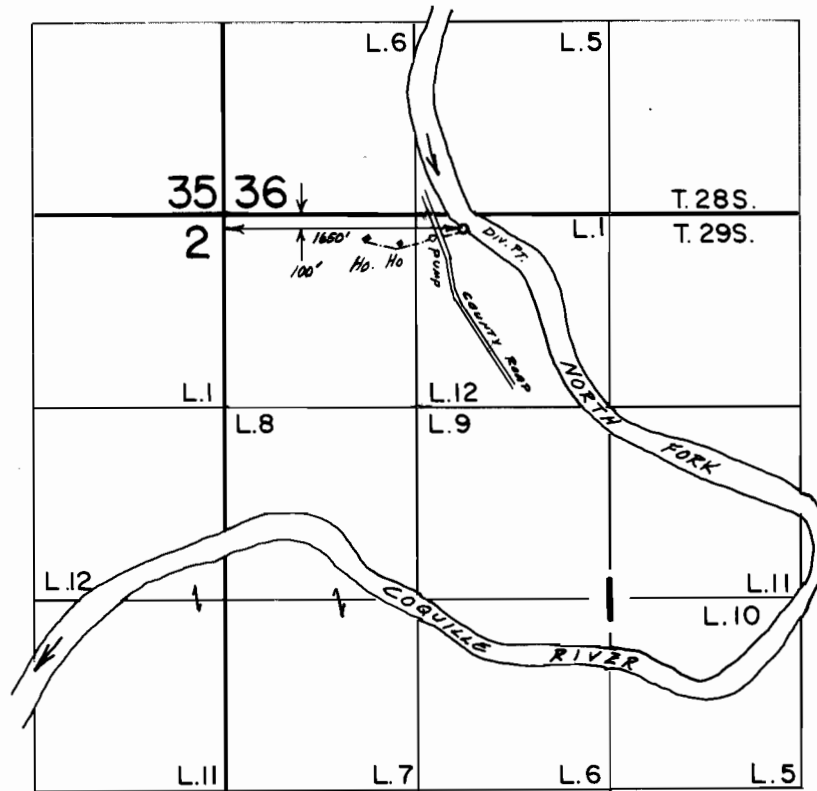

Scale 1" = 1320'

FINAL PROOF SURVEY UNDER

Application No. 6.3255. Permit No. 47034.....
IN NAME OF

CHARLES W. & MIRIAM B. SAAR.....

Surveyed June 19.. 1990., by B.S. JAMES.....