


T. 40 & 41 S., R. 8 W., W. M.

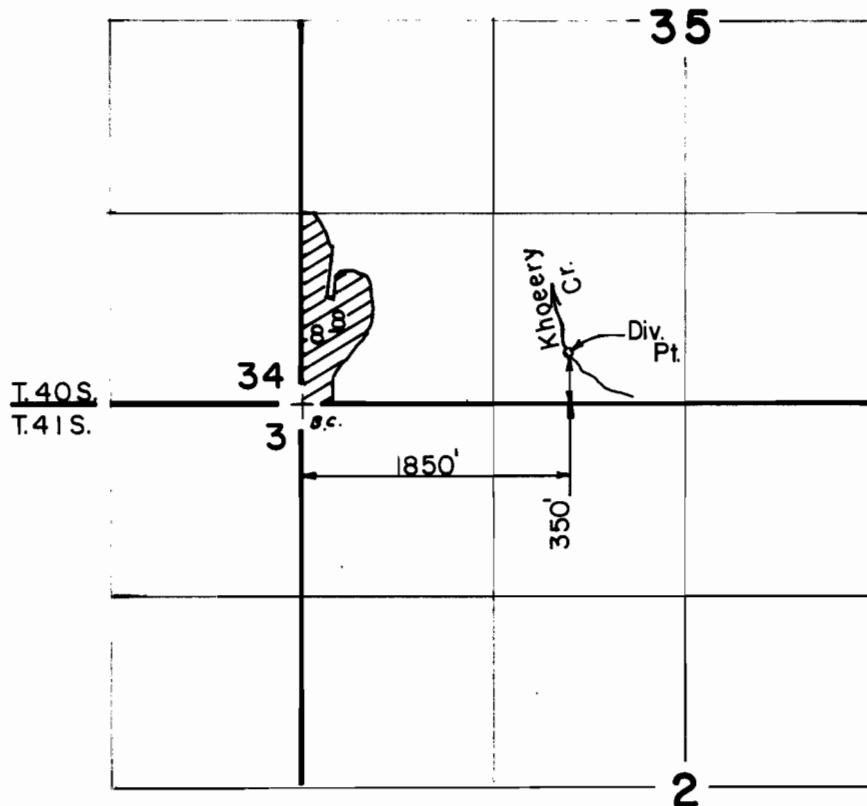

Scale: 1" = 1320'

FINAL PROOF SURVEY
UNDER

Application No. ~~64922~~ Permit No. ~~47623~~
IN NAME OF

LAUREL OLIVOLO

Surveyed APR. 12. 1988., by R.S. JAMES.....