
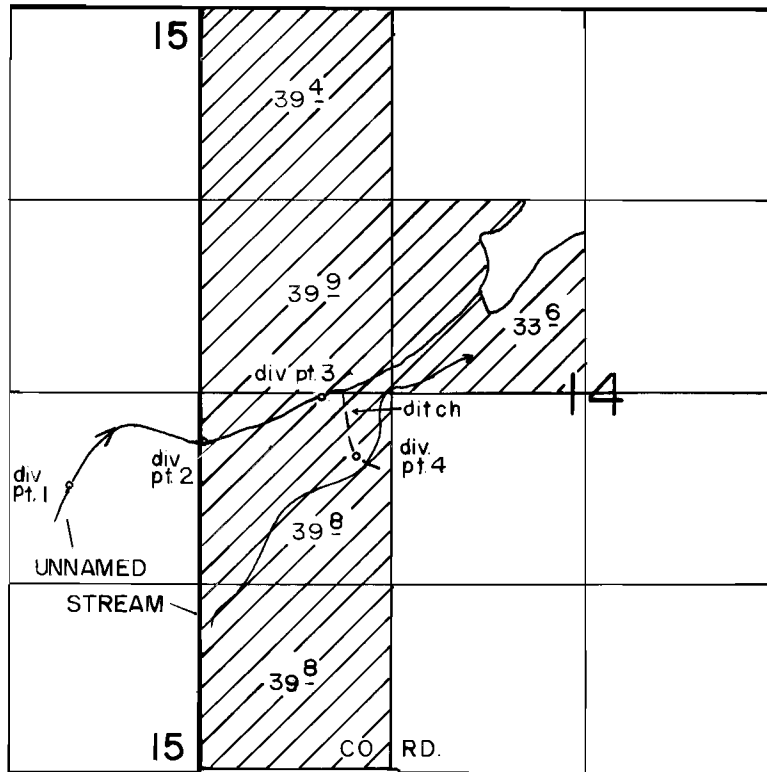


T. 7 S., R. 38 E., W.M.

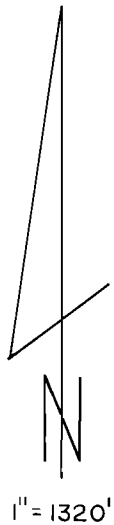

DIV PT 1 1980' N & 880' W FROM SE COR. SEC. 15
DIV PT 2 2300' N & 20' E FROM SW COR. SEC. 14
DIV PT 3 2590' N & 830' E FROM SW COR. SEC. 14
DIV PT 4 2150' N & 1040' E FROM SW COR. SEC. 14

SUPPLEMENTAL IRRIGATION

FINAL PROOF SURVEY UNDER

Application No. 65208 Permit No. 47874
IN NAME OF

ROGER W. SMITH

Surveyed AUGUST 7 1990, by K KEMP

1-9-91 DSM
41001-179-277R