



T. 9S., R. 21E., W. M.

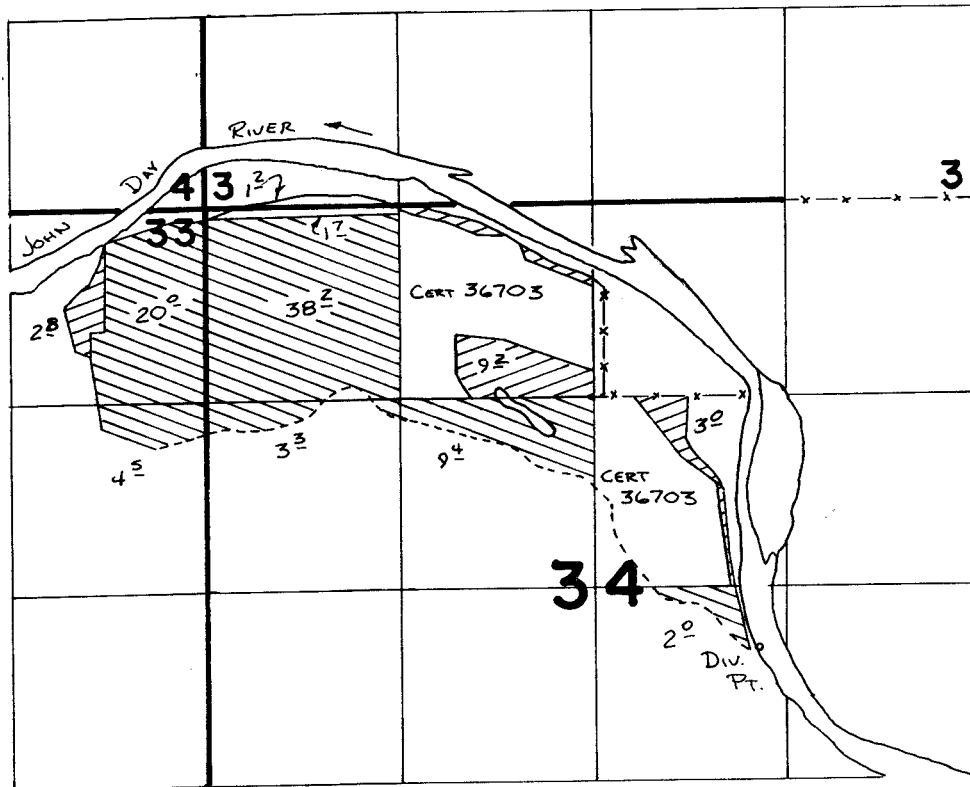

SCALE 1"=1320'

DIV. PT. LOCATION: 430'S. & 1110'E FROM CENTER COR SEC 34

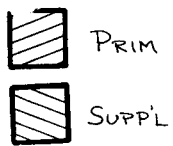

FINAL PROOF SURVEY UNDER

Application No. **67329** Permit No. **48239**
IN NAME OF

MARY MISENER

Surveyed 4-21 1986, by V.L. Church