


T. 34 S., R. 11 W., W. M.

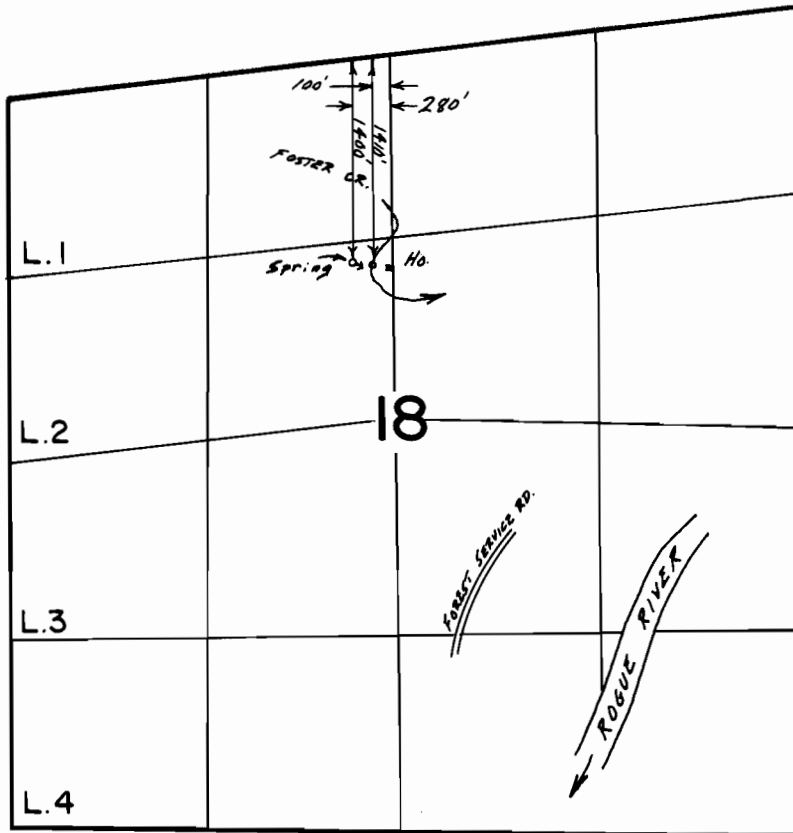

Scale 1" = 1320'

FINAL PROOF SURVEY UNDER

Application No. 68280. Permit No. 49270.....
IN NAME OF

EDWIN BILLINGS.....

Surveyed July 30, 1989, by B.S. James.....