


T. 35 S., R. 3 W., W. M.

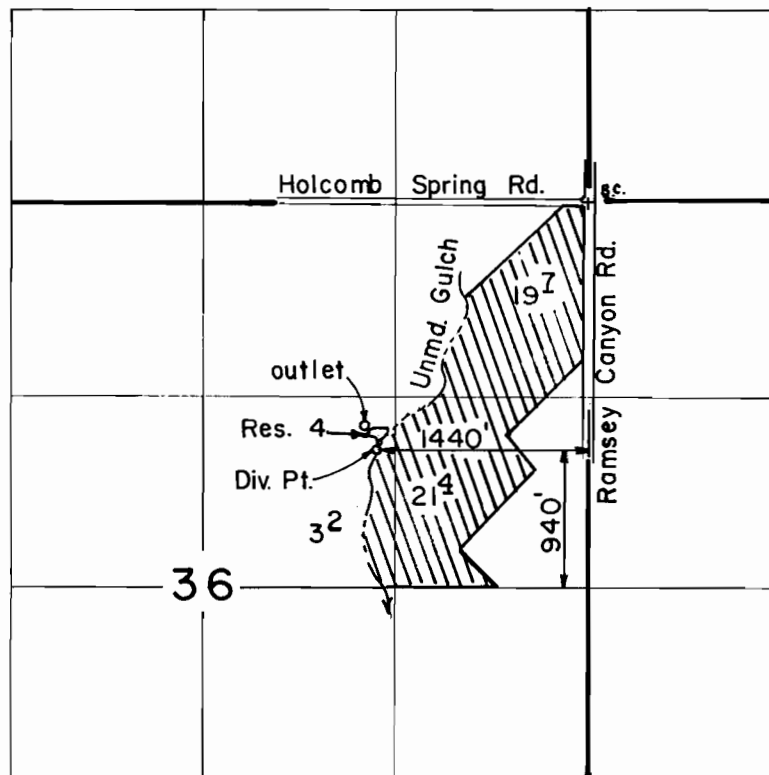

Scale: 1" = 1320'

FINAL PROOF SURVEY UNDER

R-68370 R-10508
Application No. 68376 Permit No. 49382
IN NAME OF

ASSOCIATED FRUIT COMPANY

Surveyed NOV. 15, 1990, by B. S. JAMES