


T. 26 S., R. 4 W., W. M.

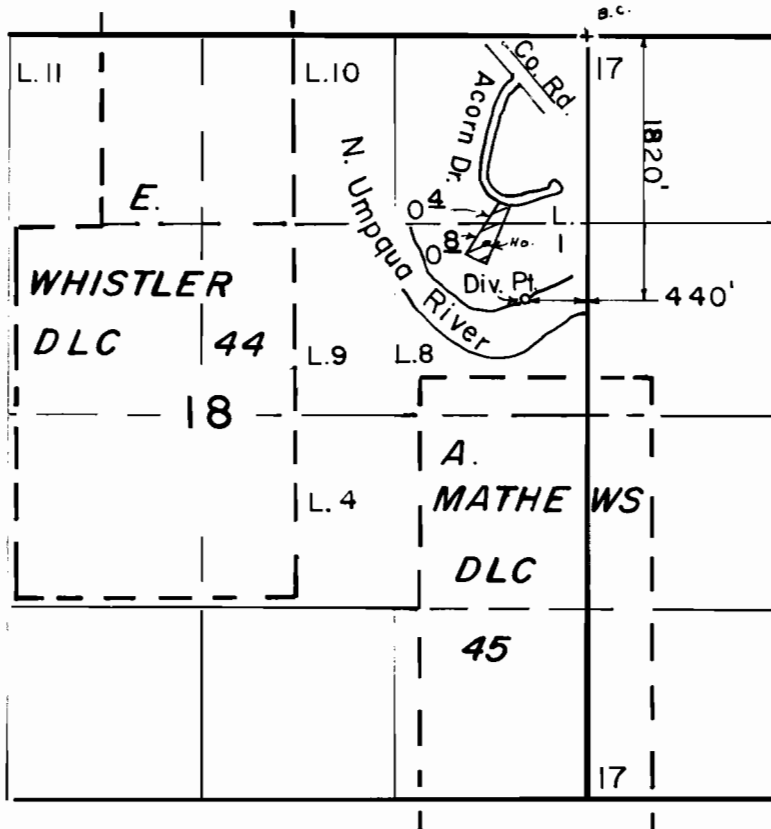

Scale: 1" = 1320'

FINAL PROOF SURVEY
UNDER

Application No. 68433 Permit No. 49418...
IN NAME OF

.....ROBERT.....E.....HINKLE.....

Surveyed AUG. 9.. 19.90, by B..S...JAMES...