


T.26S., R.12W., W.M.

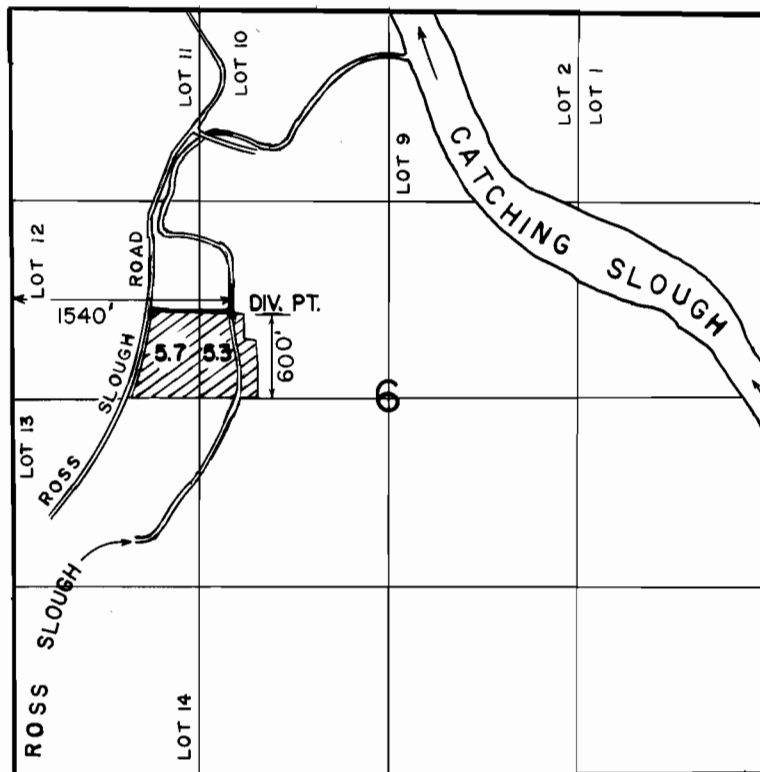

SCALE: 1" = 1,320'

FINAL PROOF SURVEY UNDER

Application No. 68955 Permit No. 49882....
IN NAME OF

.....DELBERT E. ATKINS.....

Surveyed SEPT. 17. 1990., by J.C. LARSON...