


NOTE: THIS MAP IS FOR THE LOCATION OF WATER RIGHTS AND IS NOT TO PROVIDE
LEGAL DIMENSIONS OR LOCATION OF PROPERTY LINES.

T.21S.,R.2W.,W.M.
SW 1/4,SECTION 18

18

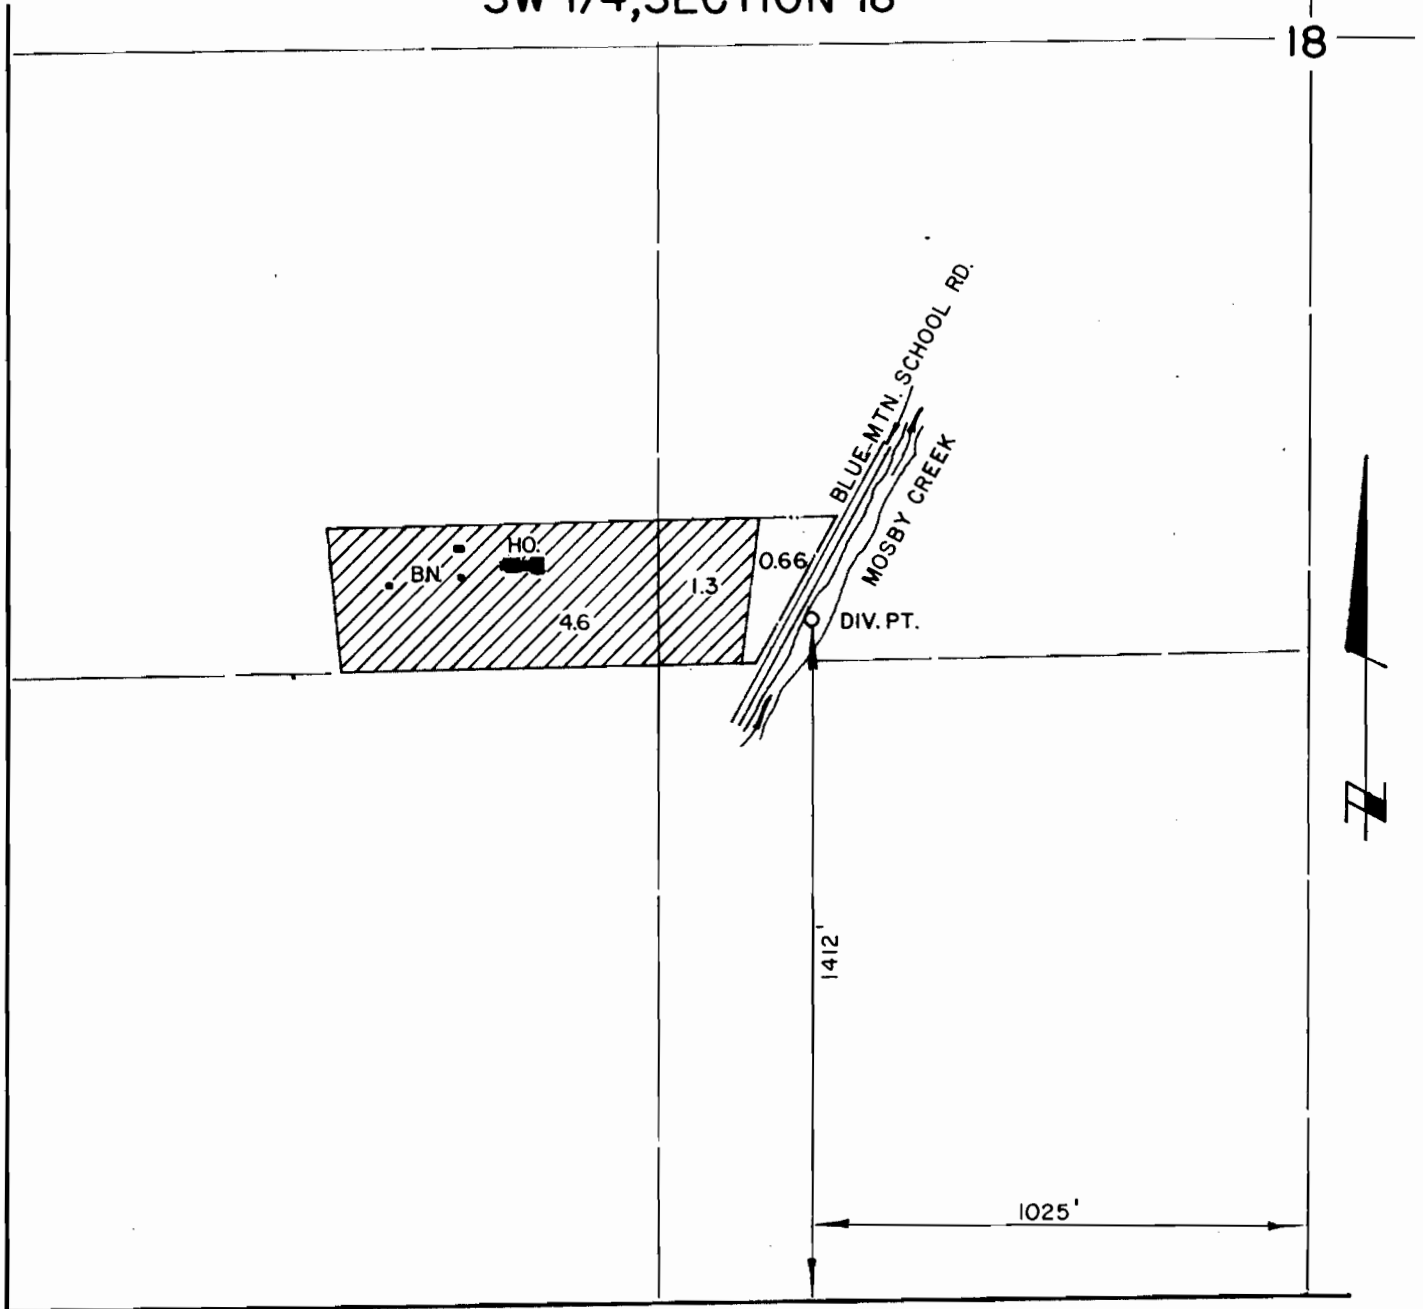

SCALE: 1" = 400'


FINAL PROOF SURVEY

UNDER

Application No. 69195... Permit No. 50128..
IN NAME OF

CHARLES E. MISSAR

Surveyed JUNE 20, 1990, by

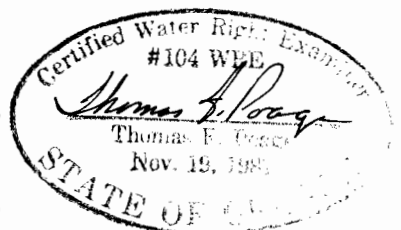

REVISED: 9/10/90