


INTERSTATE
84

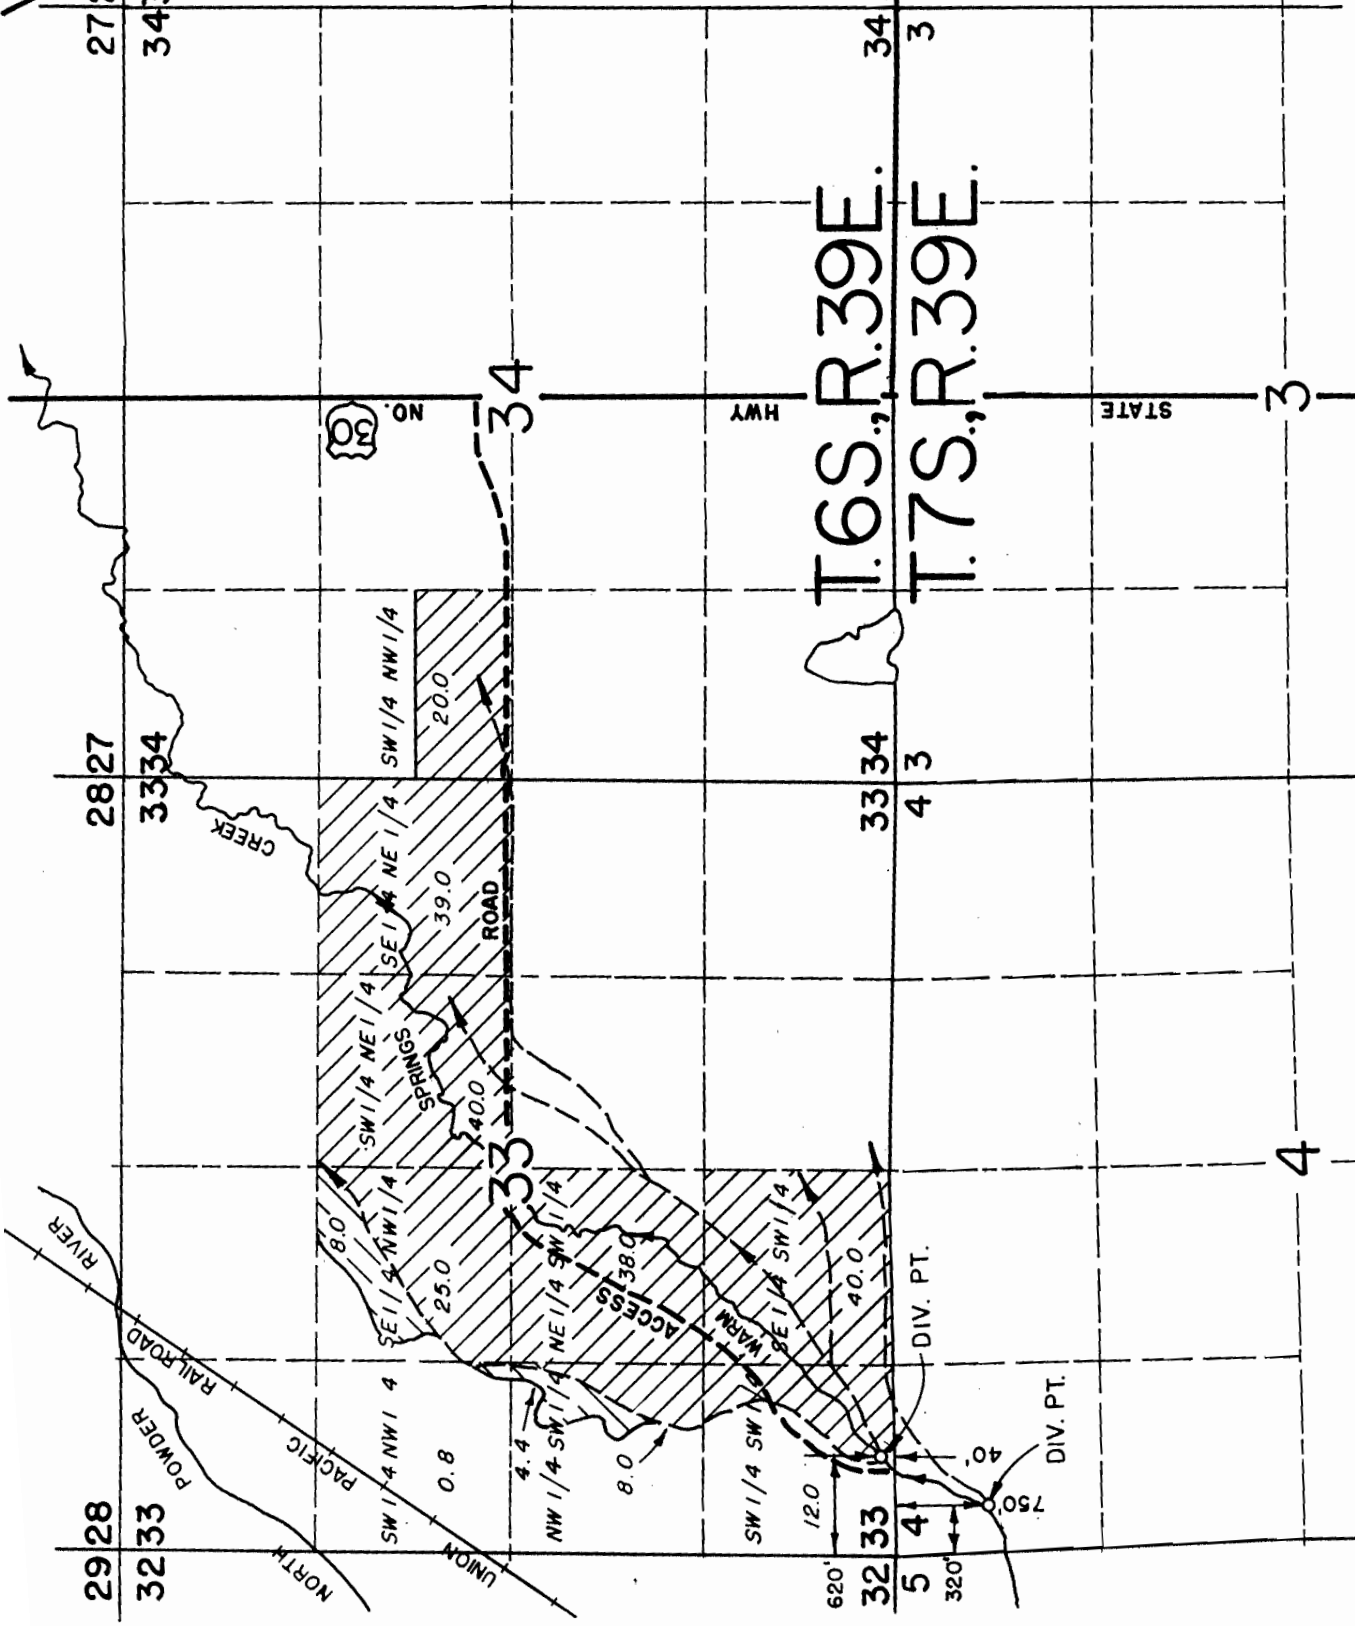

FINAL PROOF SURVEY

UNDER


Application No. 69201 Permit No. 50664

IN NAME OF

PETER W. SCHOENINGH, JR.


Surveyed Aug. 6, 1989 by JAMES D. HANLEY

1" = 1320'

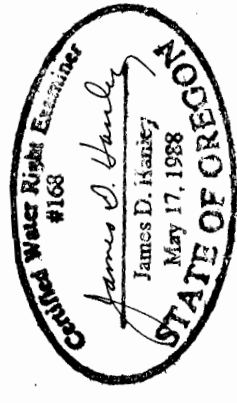

T.6S., R.39E. T.7S., R.39E.

Irrigated land but not
under Permit No. 50664

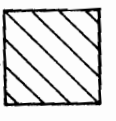

Land irrigated under
Permit No. 50664

