


FINAL PROOF SURVEY UNDER

Application No. 69412 Permit No. 50371
IN NAME OF

PETER W. SCHOENINGH JR.

Surveyed Aug. 6, 1989, by JAMES D. HANLEY

JAN 2 1991

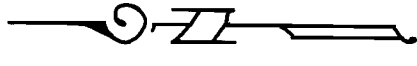

1" = 1320'

