


POSED POINT  
DIVERSION

ent ROD Cert #1223, Transfer Upstream

Present P.O.U. Transfer to Pond #1 Sec 13 T45 R11E and to Ponds #3, #4, #5 in Sec 18 T45, R12E, W.M.

T. 45., R. 11  
T. 45., R. 12

Transfer 0-40

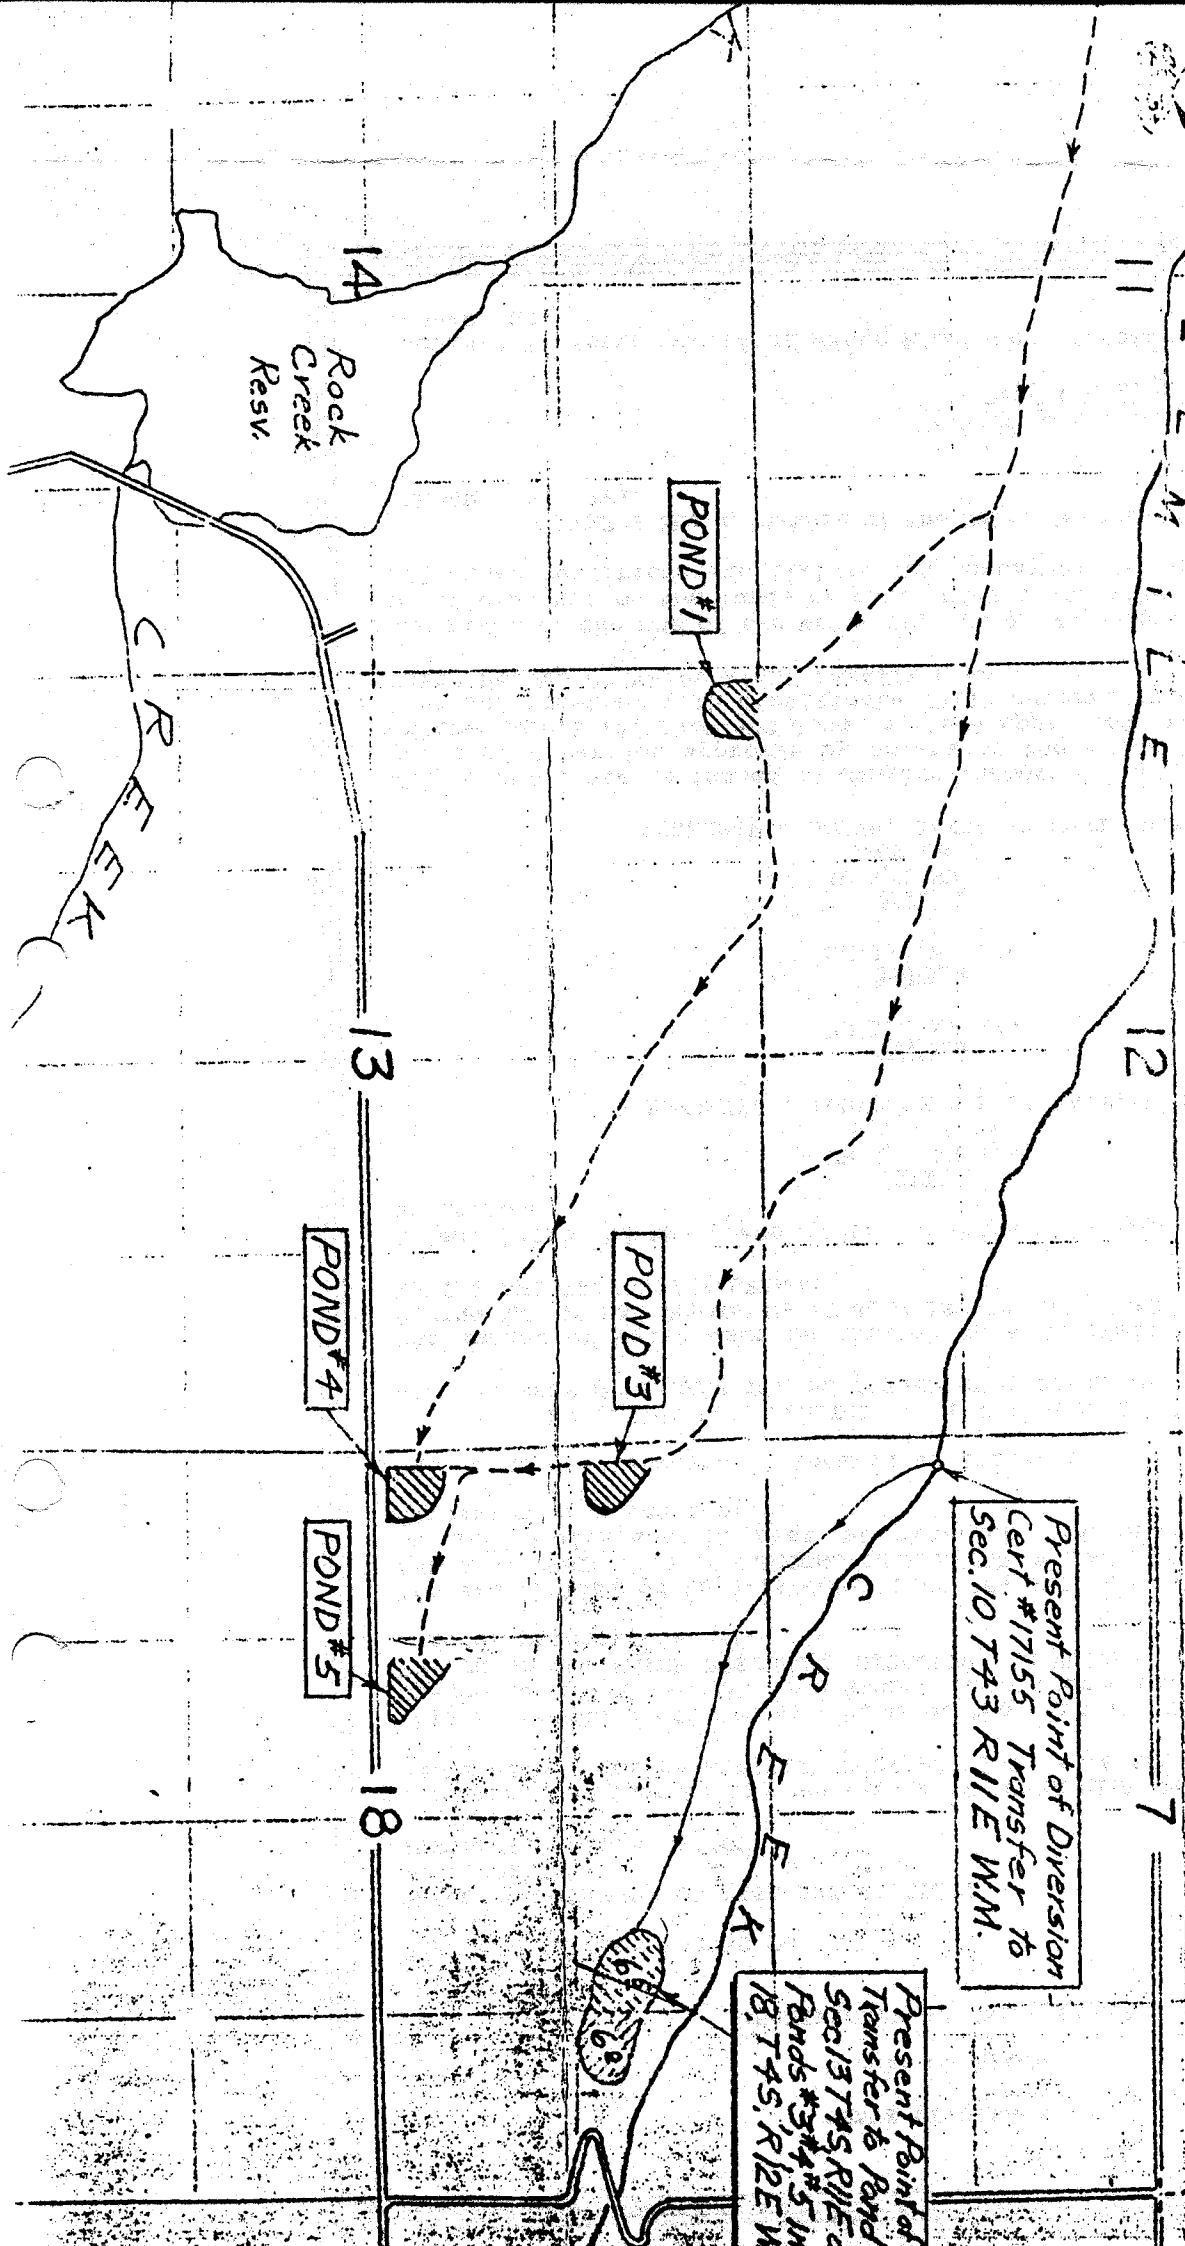

Present Point of Diversion  
Cert #17155 Transfer to  
Sec. 10 T43 R11E W.M.

Present Point of  
Transfer to Pond  
Sec 13 T45 R11E  
Ponds #3, #4, #5 in  
18, T45, R12E W.M.

14  
Rock  
Creek  
Resv.

12

13

7

18

POND #1

POND #3


POND #4

POND #5

C R E E K

C R E E K

FINAL PROOF SURVEY INSPECTED  
APPLICATION MAP

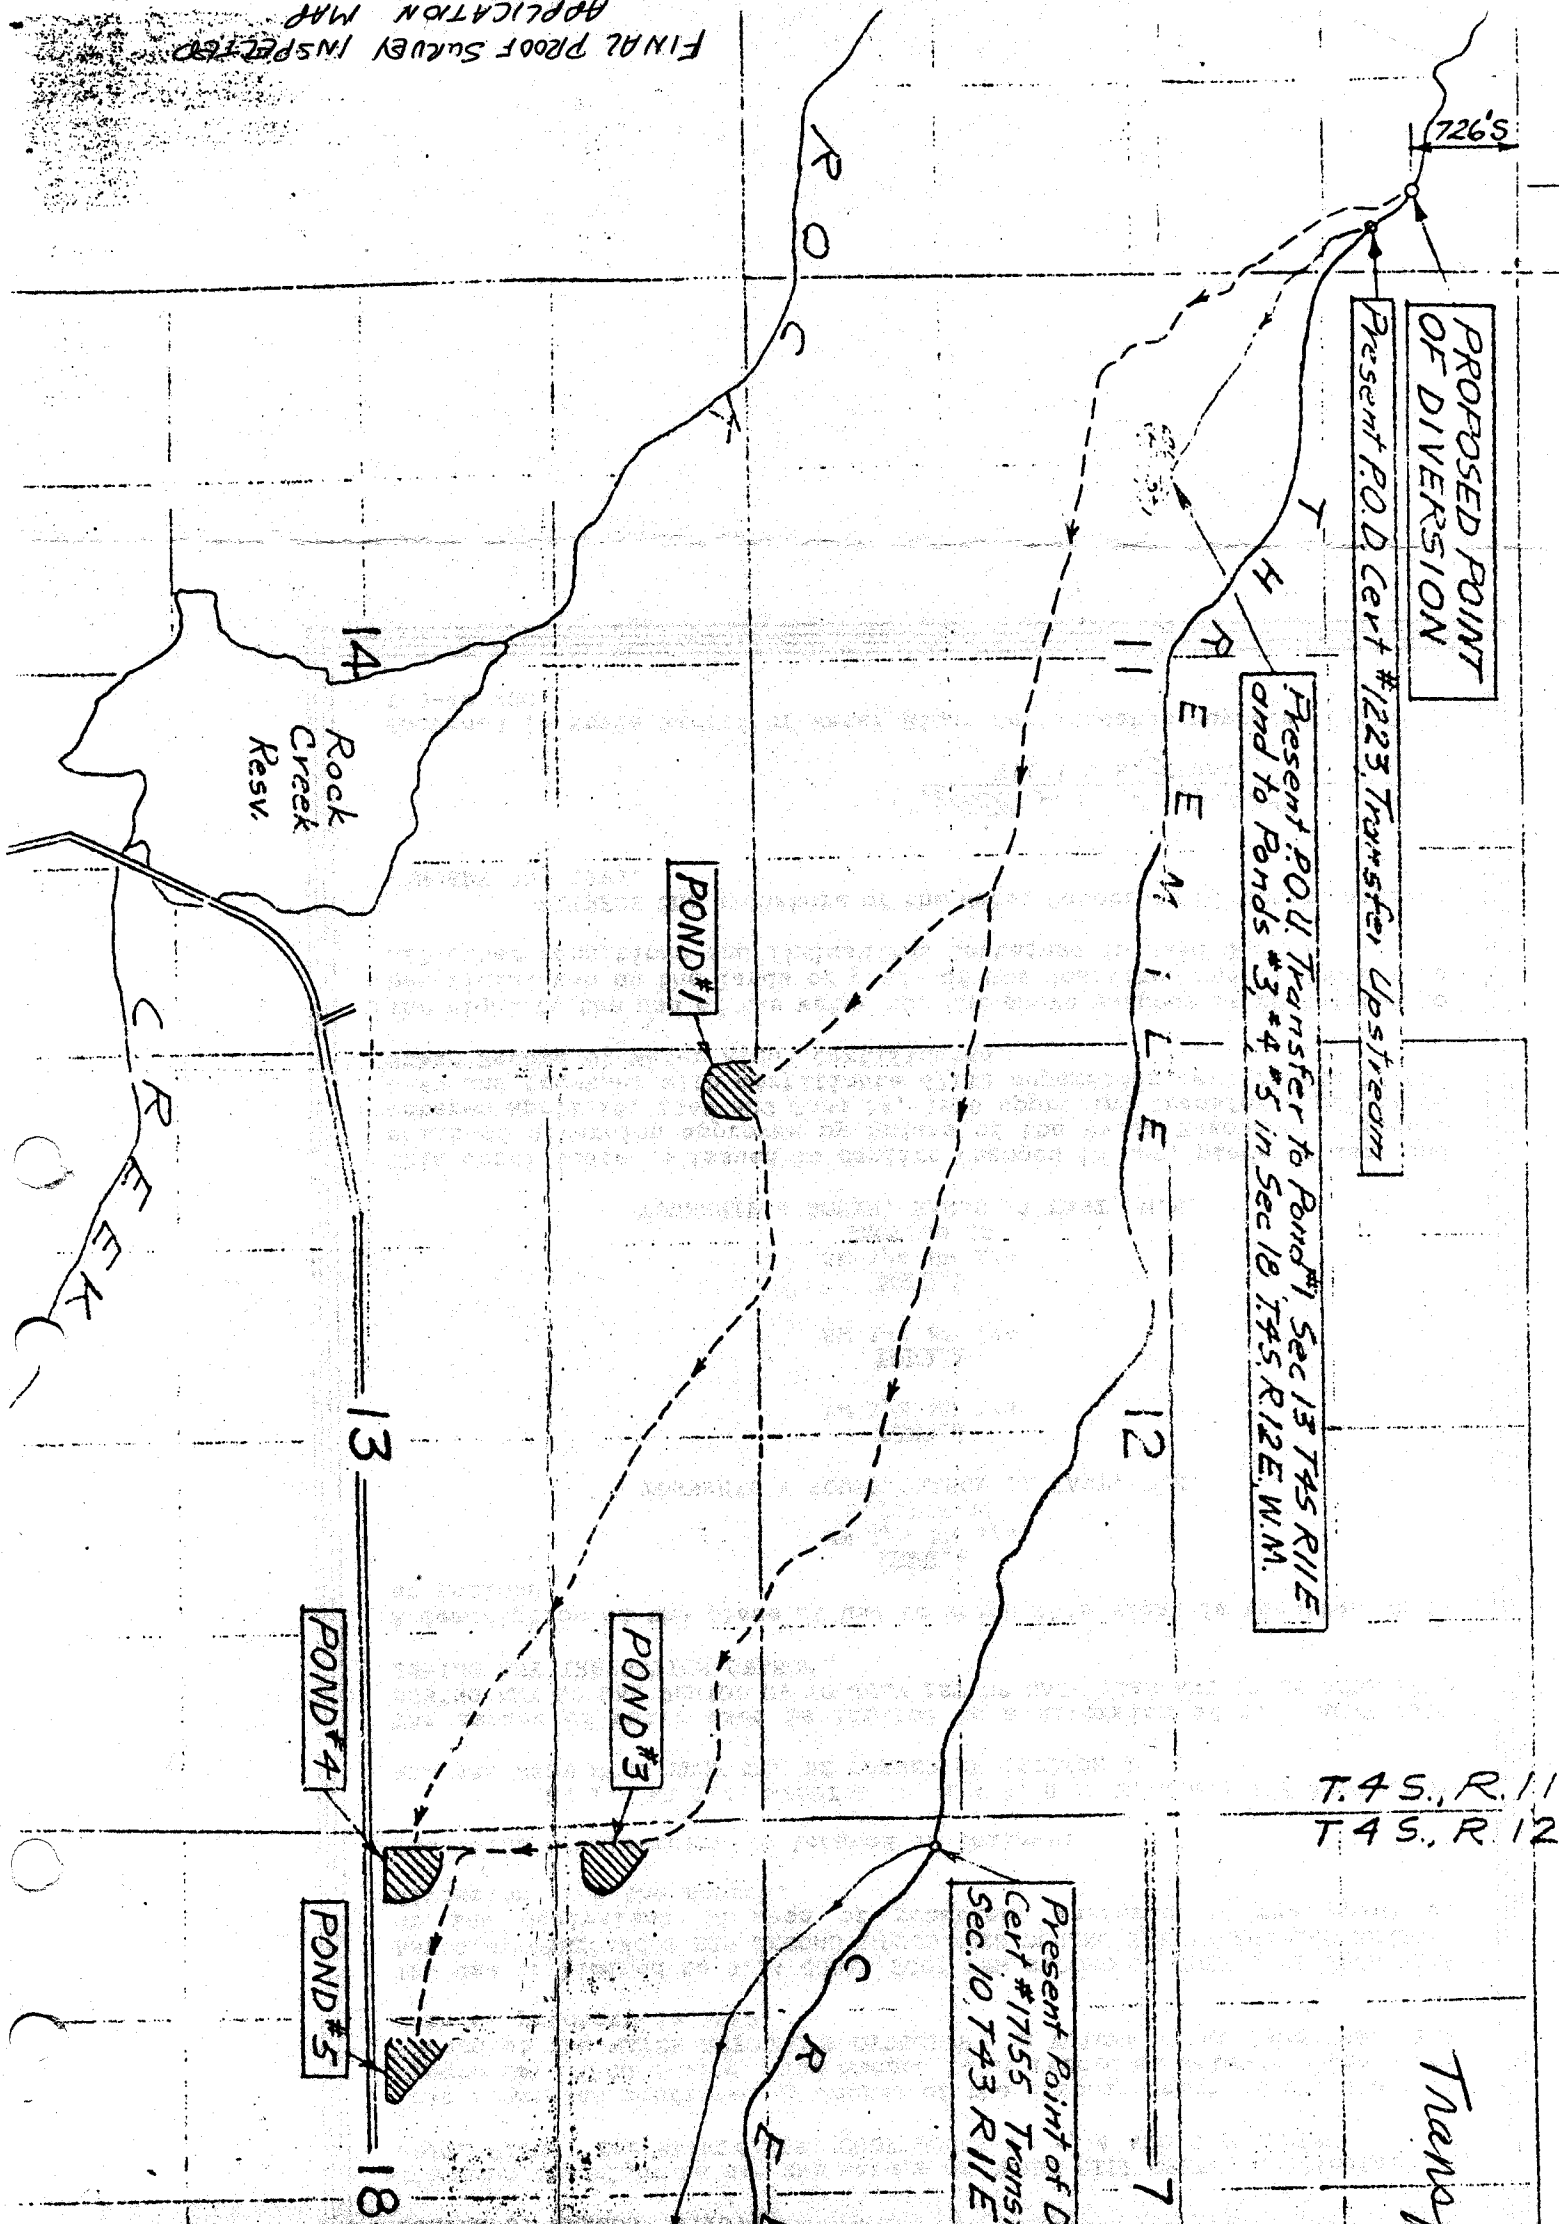

PROPOSED POINT  
OF DIVERSION

Present P.O.D. Cert #1223 Transfer Upstream

Present P.O.D. Transfer to Pond #1 Sec 13 T45 R11E  
and to Ponds #3, #4, #5 in Sec 18 T45 R12E, W.M.

Present Point of D  
Cert #17155 Transf.  
Sec. 10 T43 R11E

T. 45., R. 11  
T. 45., R. 12

Threemile

726'S

R  
O  
C  
K  
C  
R  
E  
E  
K

T  
H  
R  
E  
E  
M  
I  
L  
E  
C  
R  
E  
E  
K

POND #1

POND #3

POND #4

POND #5

14  
Rock  
Creek  
Resv.

C  
R  
E  
E  
K

13

12

18

7