


PROPOSED POINT DIVERSION

Prop. P.O.D. Cert #1223, Transfer Upstream

Present P.O.D. Transfer to Pond #1, Sec 13 T45 R11E and to Ponds #3, #4, #5 in Sec 18 T45, R12E, W.M.

Transfer 0-40

T45, R11 T45, R12

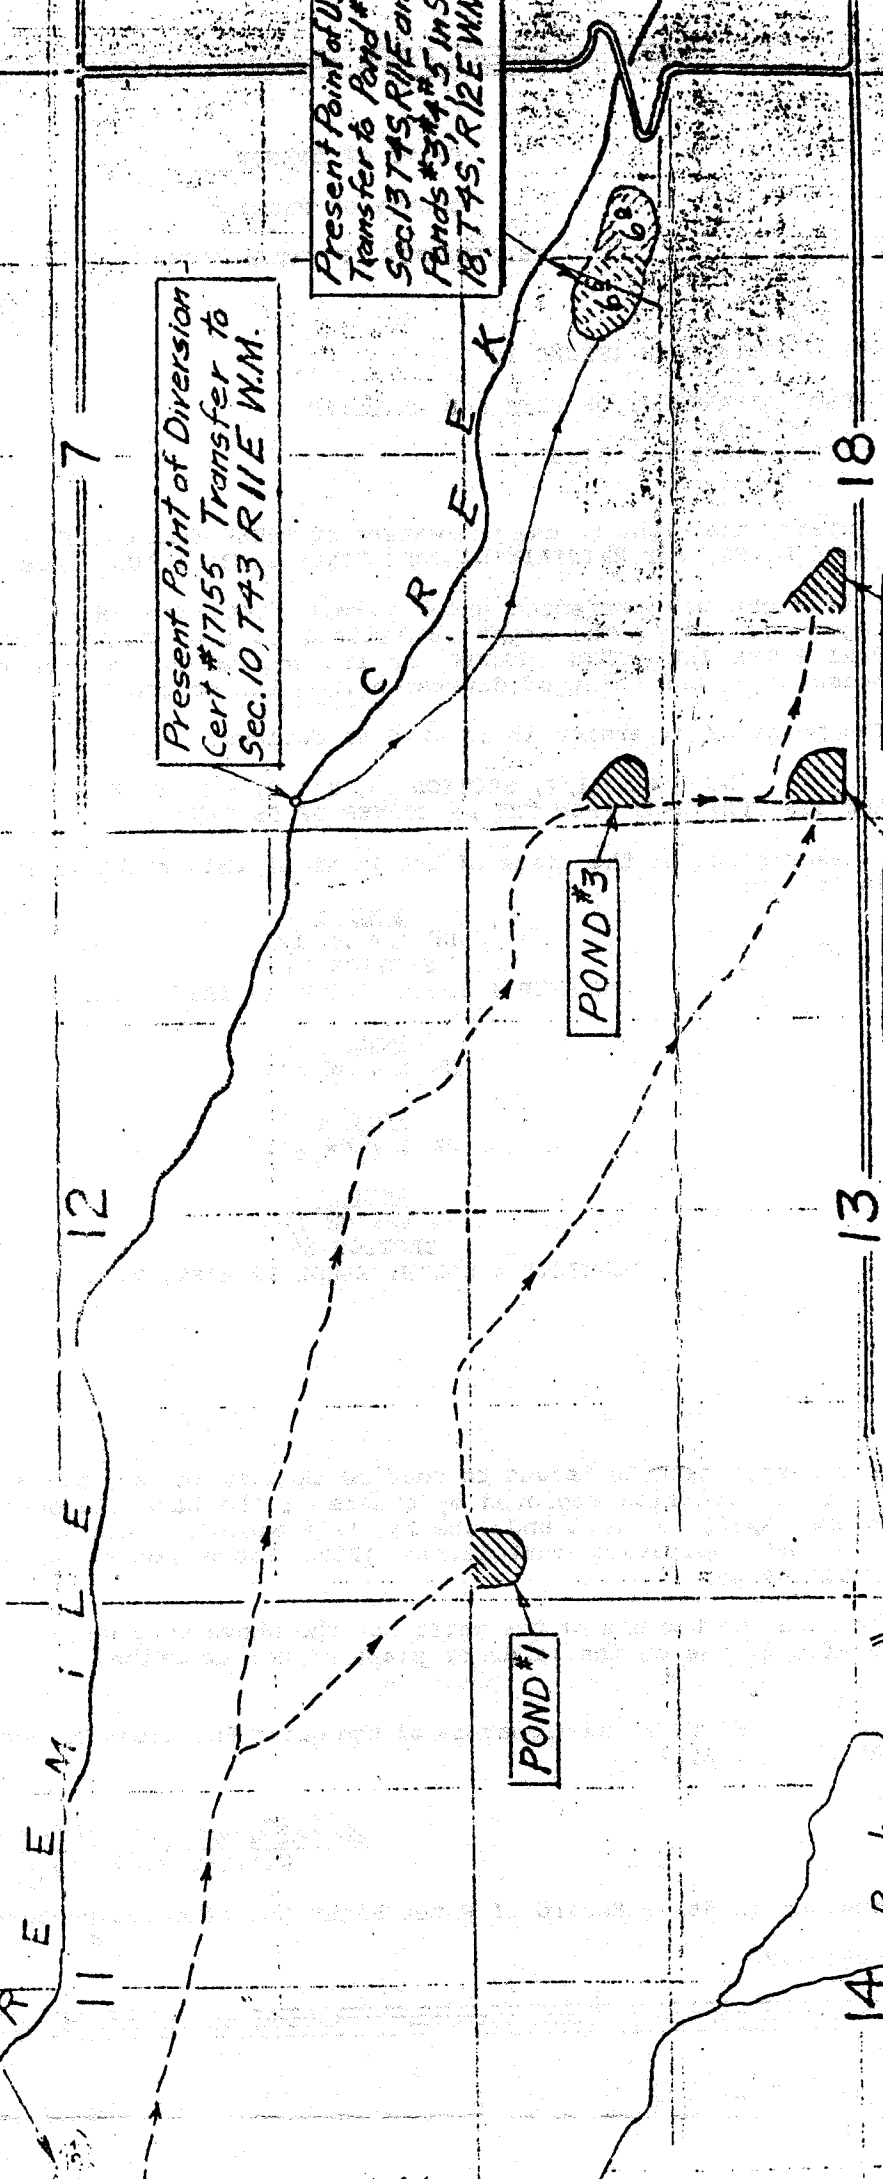

Present Point of Diversion Cert #17155 Transfer to Sec. 10, T43 R11E W.M.

Present Point of Div. Transfer to Pond #, Sec 13 T45, R11E on Ponds #3, #4, #5 in S. 18, T45, R12E W.M.

POND #3

POND #1

POND #4

POND #5

13

18

12

17

14

Rock Creek Resv.

T H R E E M I L E

C R E E K

C R E E K

Transf

T.45, R.11
T.45, R.12


Present Point of Div
Cert #17155 Transfe
Sec. 10, T.43 R.11 E.W.

Present P.O.U. Transfer to Pond #1, Sec 13 T.45 R.11 E.

Present P.O.D. Cert #1223, Transfer Upstream

PROPOSED POINT
OF DIVERSION

726'S

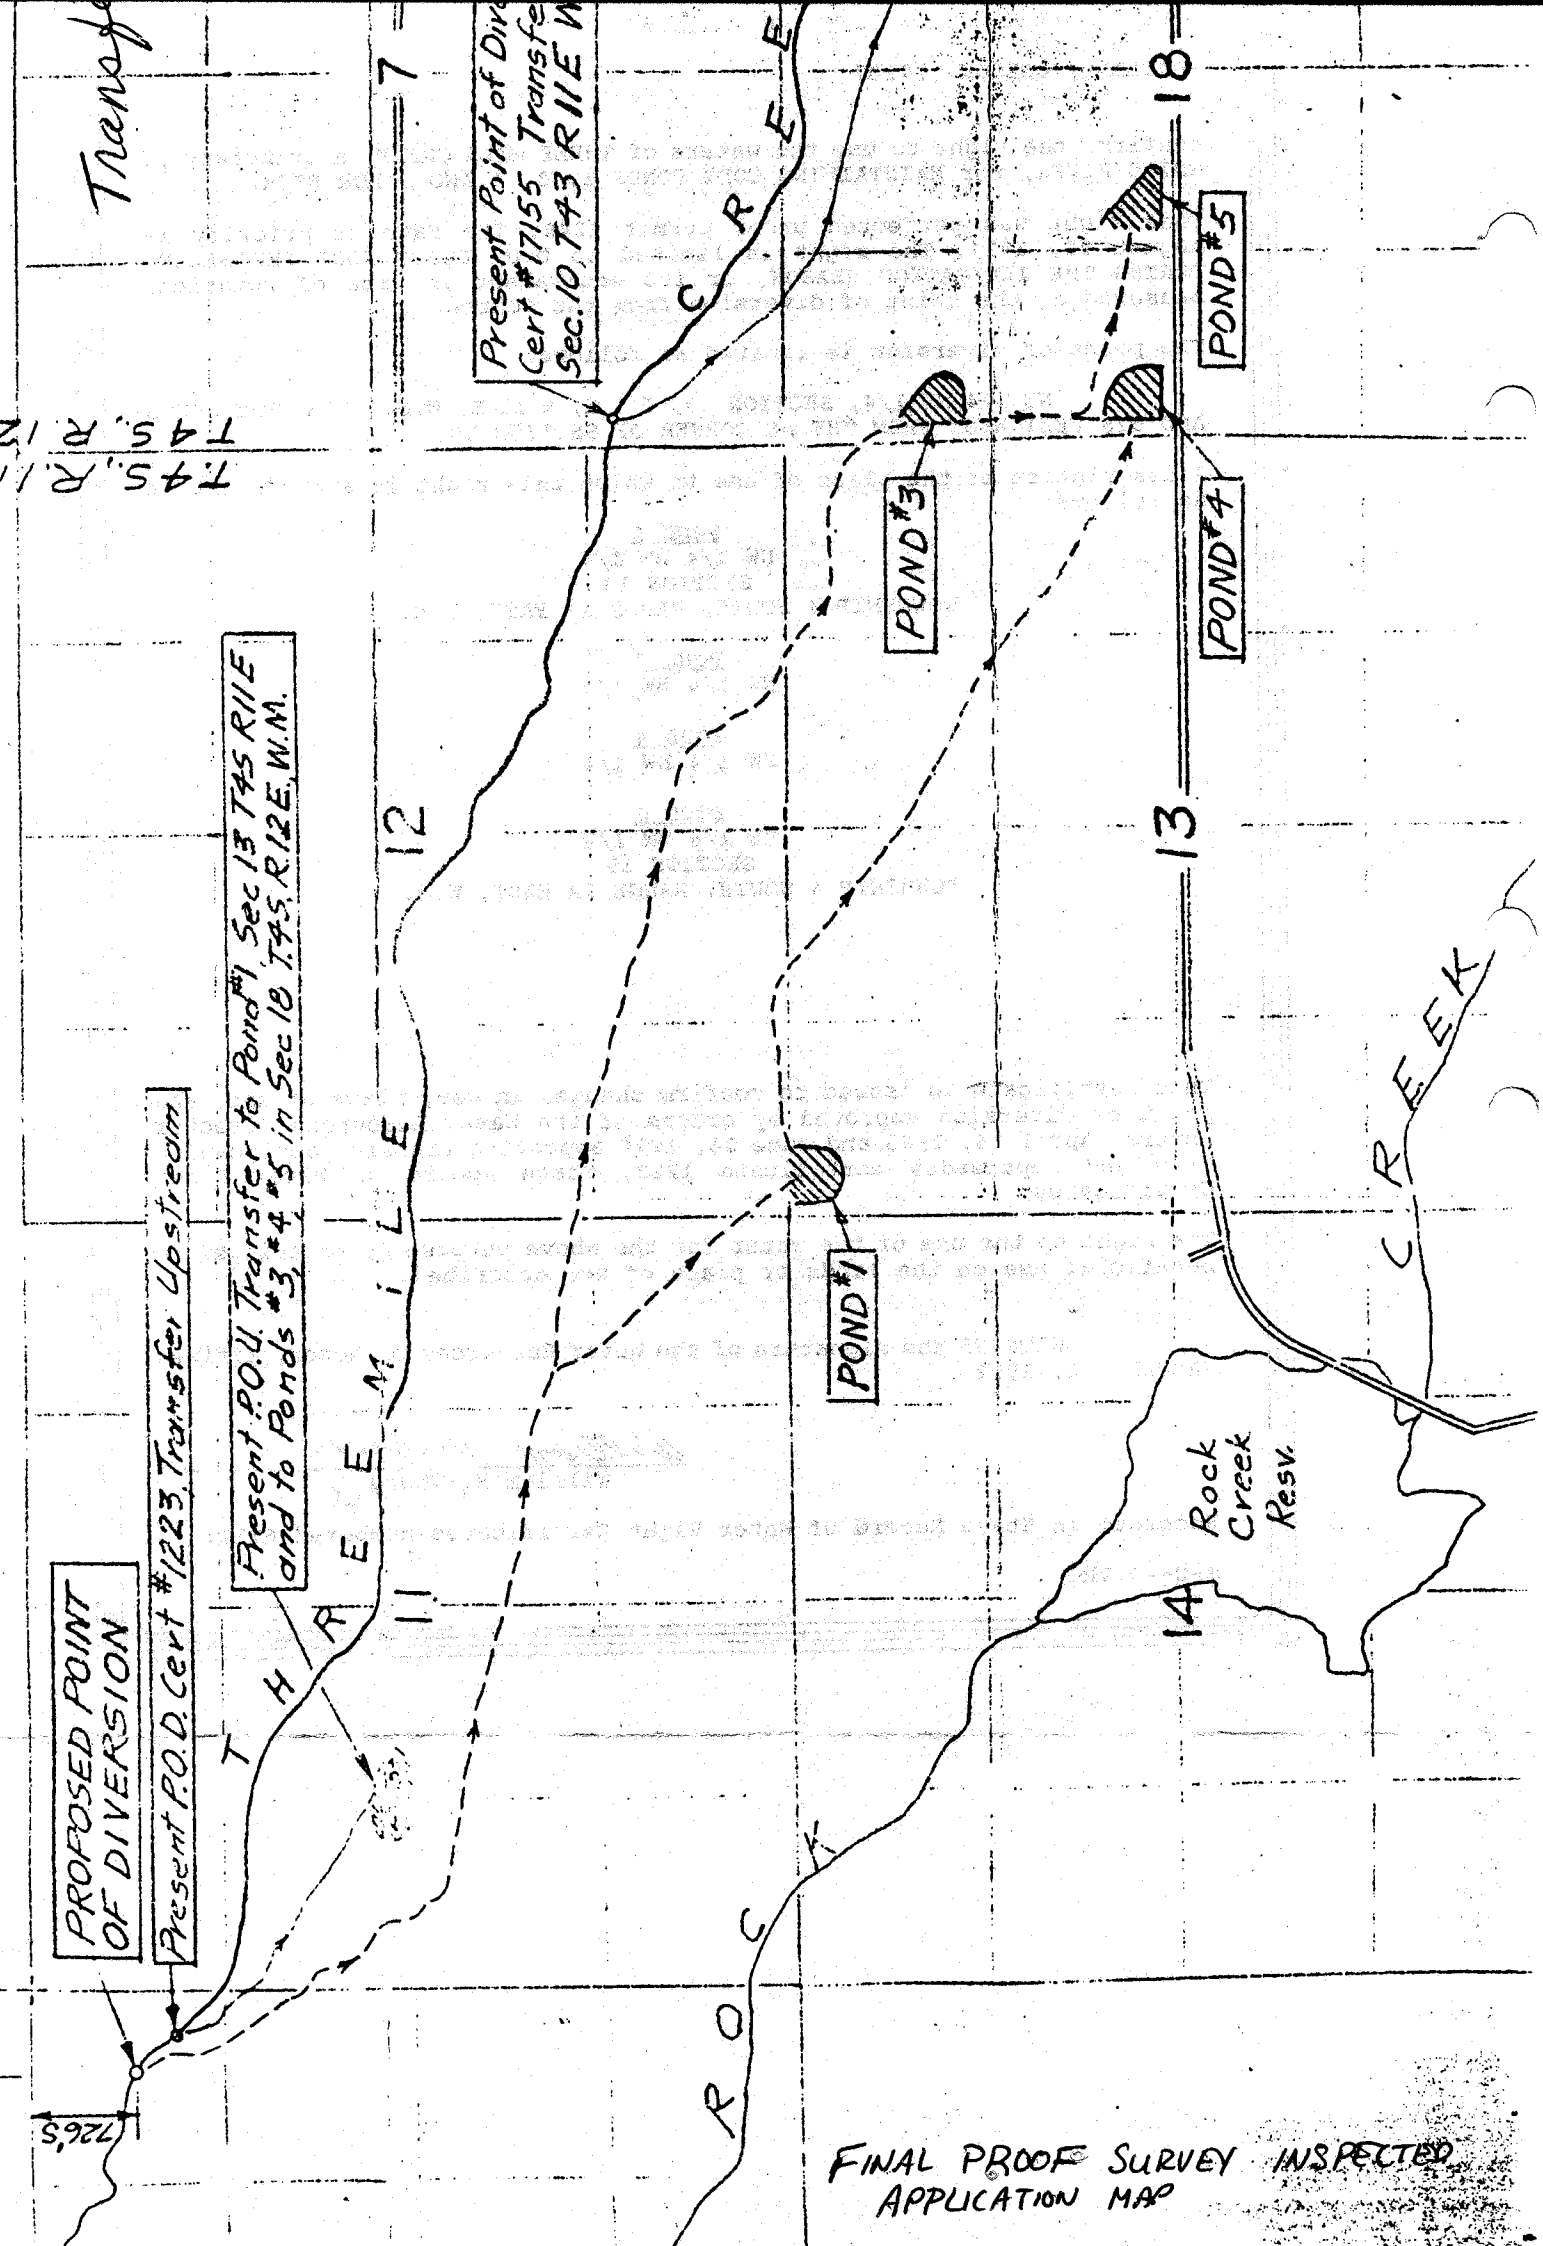

FINAL PROOF SURVEY INSPECTED
APPLICATION MAP