

U-175

~~U-321~~

T. 17 N., R. 13 E., W.M.



FINAL PROOF SURVEY

UNDER

U-336 U-321

Application No. 11-186 Permit No. U-175

IN NAME OF

Three Mile Irrigation Cooperative, Inc.

Surveyed June 11 1952, by H. L. Coffman

DU-38

Affidavits including
The Dalles I.O. clause

Affidavits with orders entered


Geiger 1980

Booth 1976

Musser 1992

7th Day Adventist Church 1986

Wilson 1980

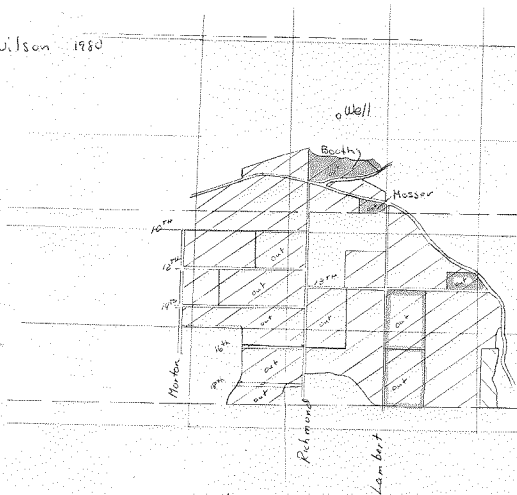

FINAL PROOF SURVEY
UNDER

U-336

U-321

Application No. U-186

Permit No. U-175

IN NAME OF

Trace of 3 mile Coop Final Proof Map

Surveyed 19..... by

Used to show affidavit