
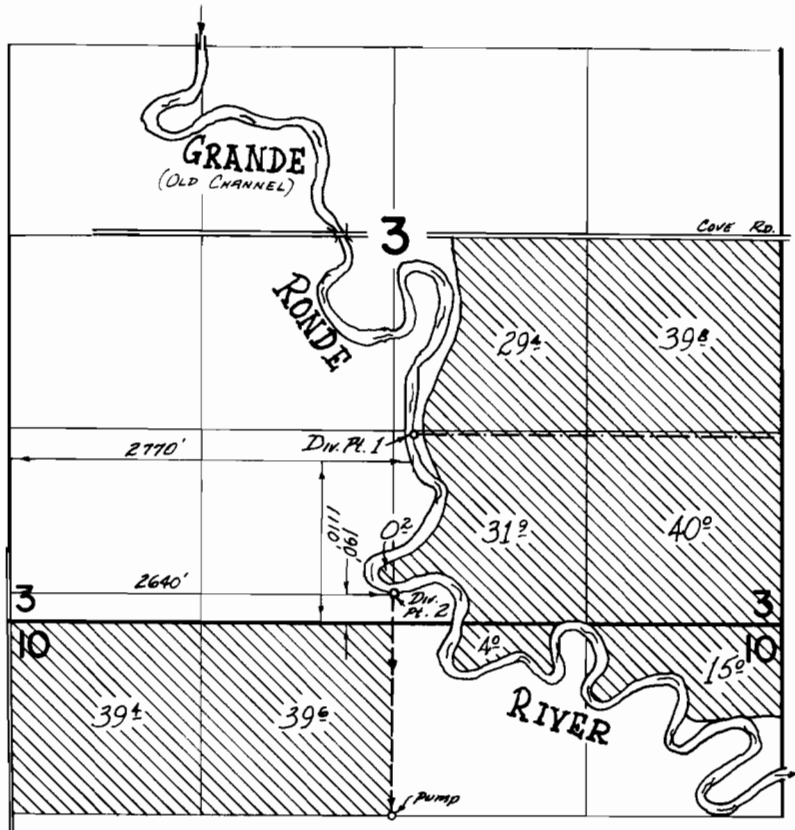


T.3S.,R.39E.,W.M.

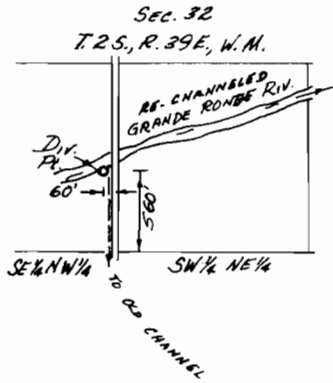

FINAL PROOF SURVEY
UNDER

Application No. 41602 Permit No. 31347
IN NAME OF

MERTON TAYLOR

Surveyed July 14 1973, by D. NORBY