


# T.3S.R.39E.WM

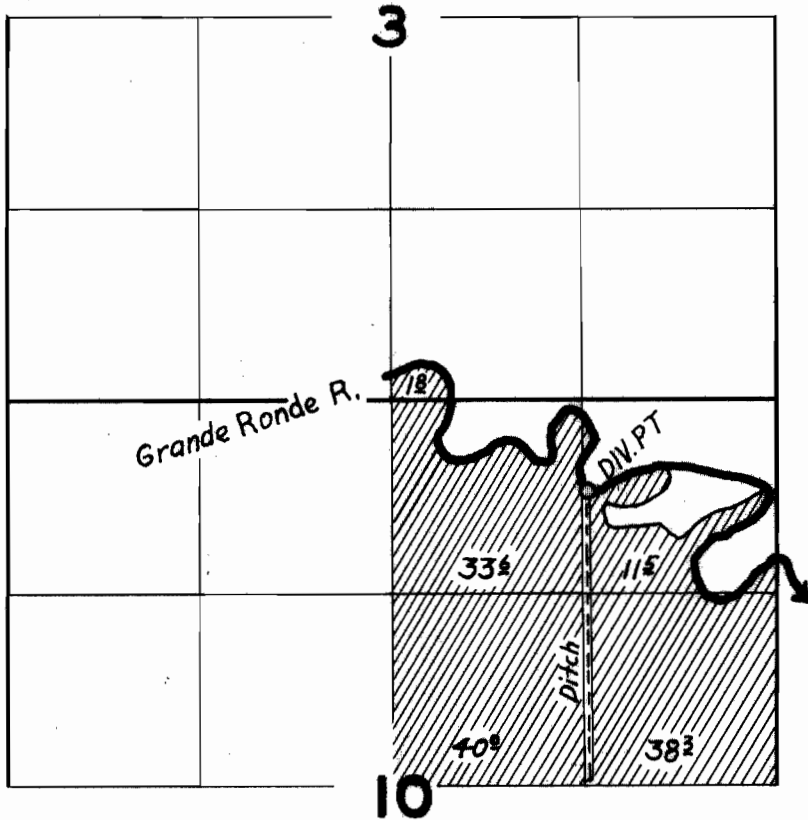

## FINAL PROOF SURVEY UNDER

Application No. 208111 ..... Permit No. 16305.....  
IN NAME OF

..... Gilbert Courtright .....

Surveyed Oct. 7, 1953, by T. Jones .....