


T.13S., R.16E., W.M.

Sec. 22

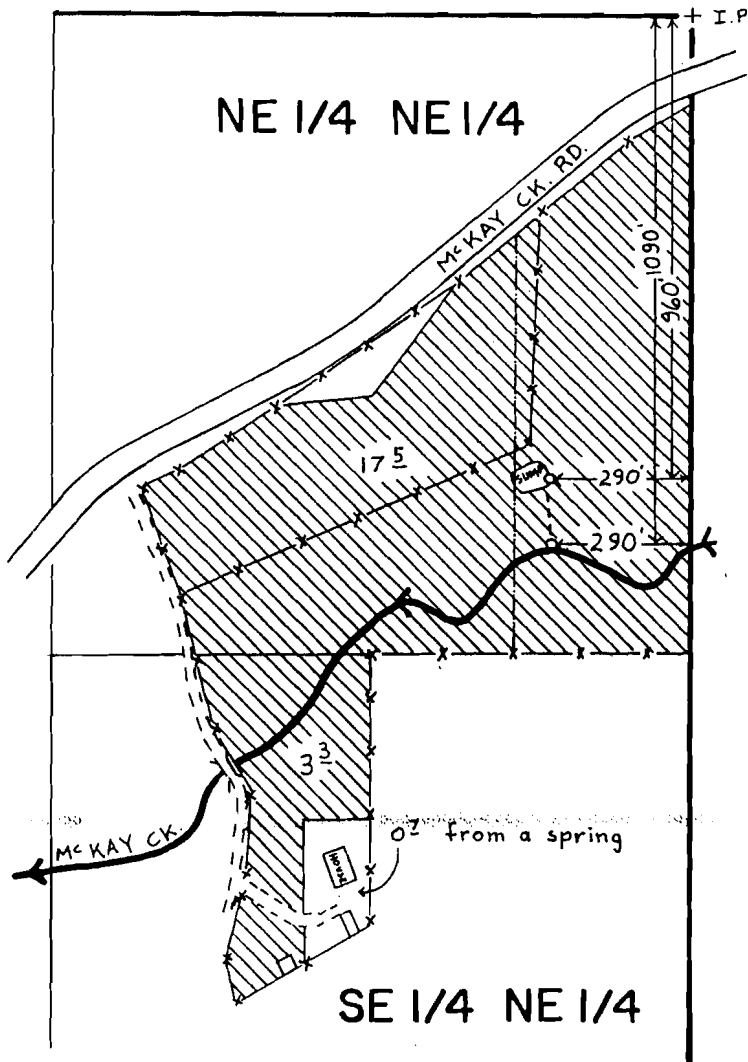

SCALE: 1" = 400'

FINAL PROOF SURVEY
UNDER

55960 41933
Application No. G-8157... Permit No. G-7517.....
IN NAME OF

RICHARD REYNOLDS & CLIFFORD REYNOLDS

Surveyed MARCH 20 1987., by M.J. MATTICK.....

Cert. 67121

2-9-90 *fil*

PTS 11-1987A MJM

G-7517

FILED 7-13-12 10:44 AM