


T.13S., R.16E., W.M.

Sec. 22

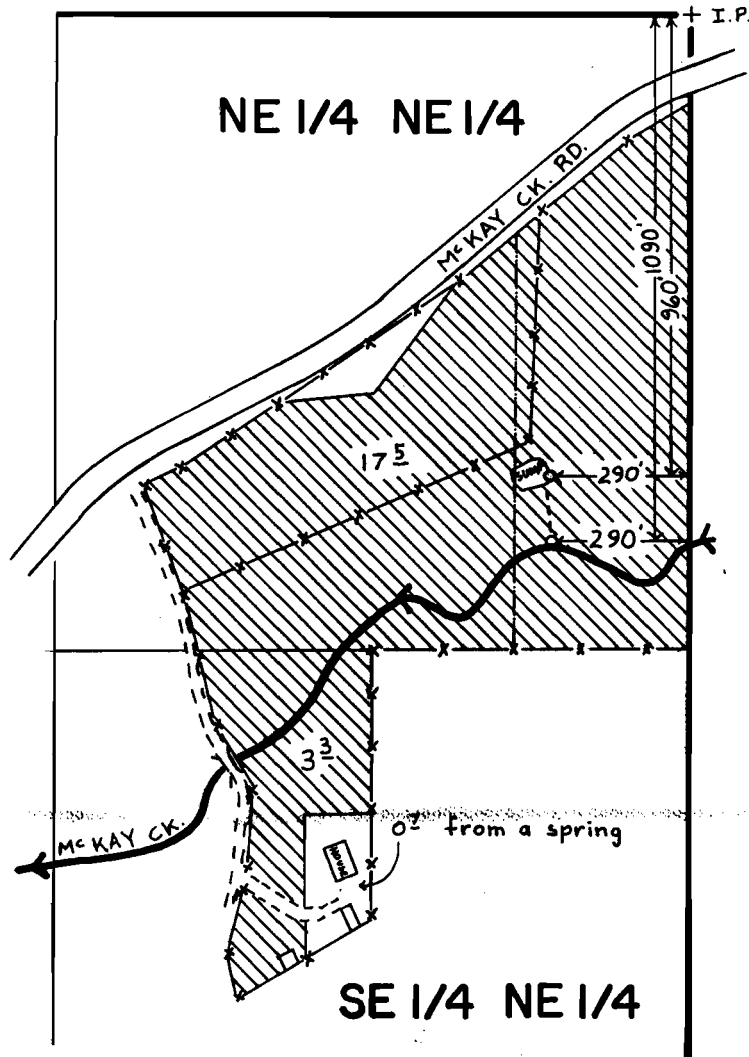

SCALE : 1" = 400'

FINAL PROOF SURVEY
UNDER

Application No. 55960 G-8157... Permit No. 41933 G-7517.....
IN NAME OF

RICHARD REYNOLDS & CLIFFORD REYNOLDS

Surveyed MARCH 20 1987... by M.J. MATTICK.....

cert. 67122

2-9-90 *fil*

PTS 11-1987A MJM

41933

Rec'd 4-15-93 WDA#11