


T. 37 S., R. 5 W., W. M.

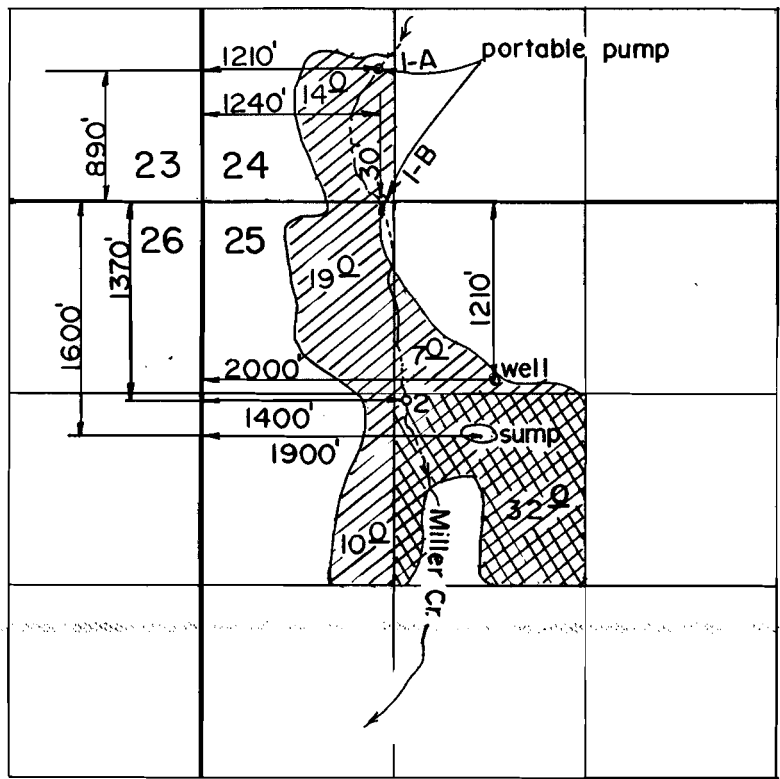

Scale: 1" = 1320'

FINAL PROOF SURVEY
UNDER

57097 42951
Application No. G-8659 Permit No. G-8066
IN NAME OF

ALBERT & ADELINE M. PONDELICK

Surveyed AUG. 23. 1988, by B. S. JAMES