


T. 37 S., R. 5 W., W. M.

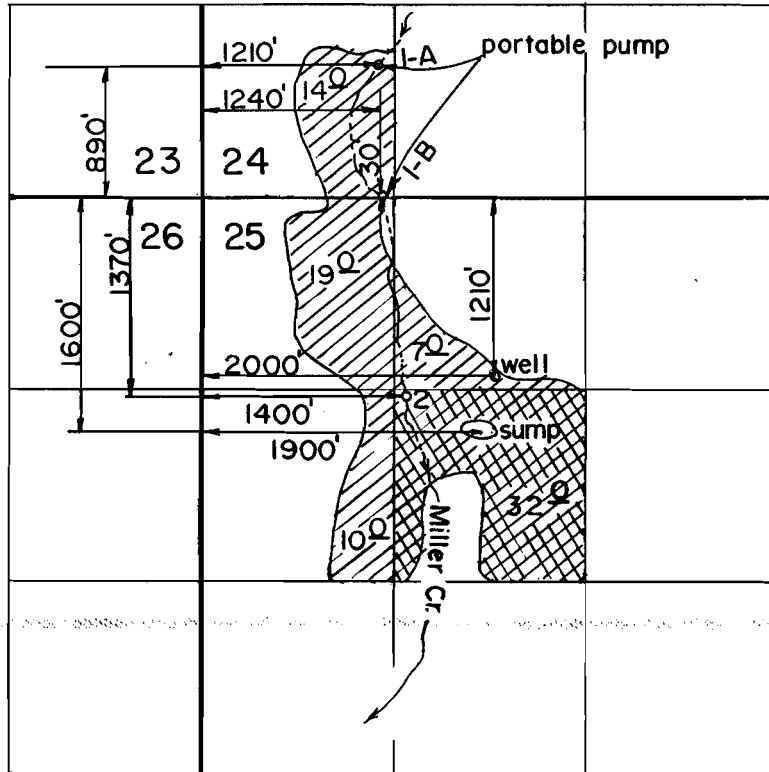

Scale: 1" = 1320'

**FINAL PROOF SURVEY**  
UNDER

57097                      42951  
Application No. G-8659    Permit No. G-8066  
IN NAME OF

**ALBERT & ADELINE M. PONDELICK**

Surveyed AUG. 23, 1988, by B. S. JAMES