


T7N, RIOW, WM SEC 27

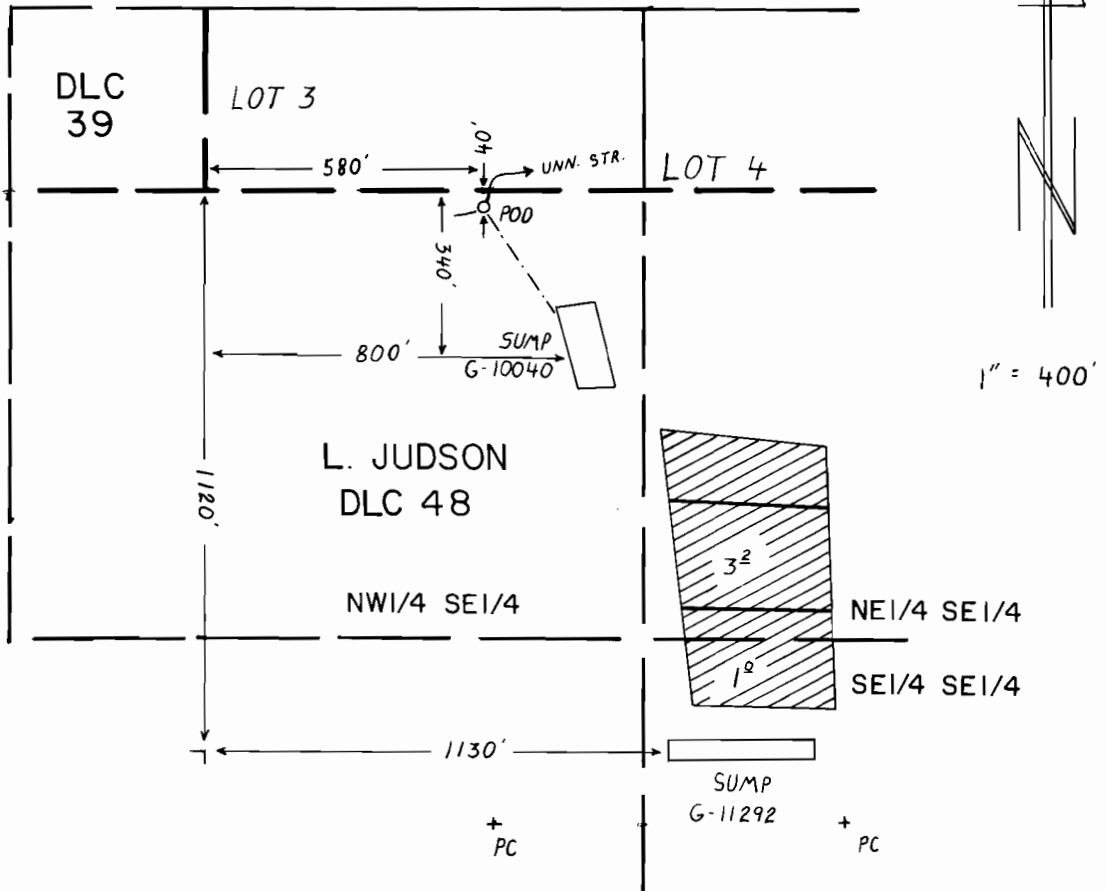

FINAL PROOF SURVEY UNDER

G-10040 G-10038
 G-11292 G-10410
 Application No. 61049 Permit No. 47472....
 IN NAME OF

JERRY BOGH

Surveyed JULY 19, 1988, by T.M. WARREN....

RWK
PTS W/FF