


T 5 S., R. 1 W., W.M.

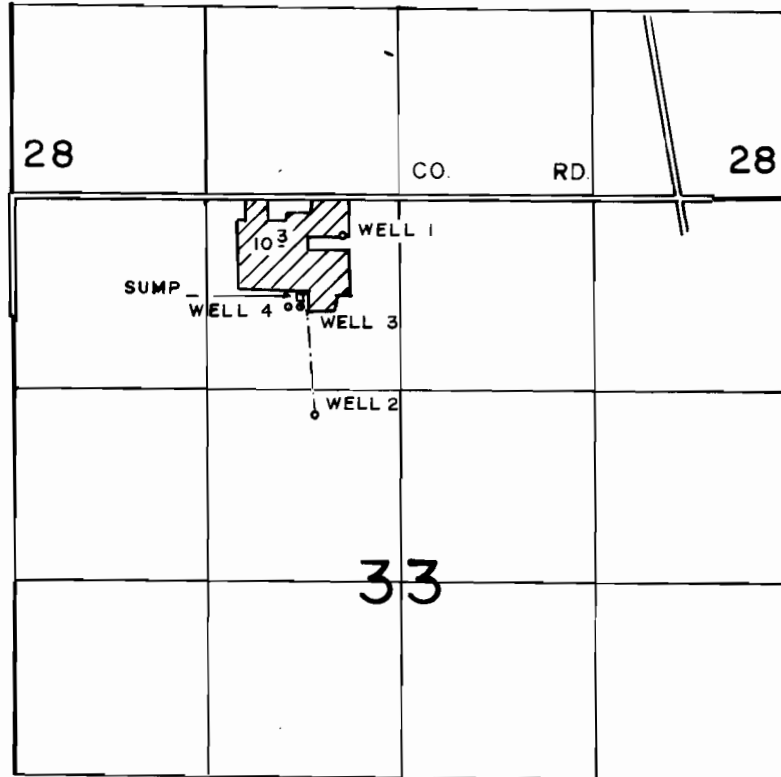

1" = 1320'

- WELL 1- 260' S & 2270' E FROM NW CORNER SEC. 33
- WELL 2- 1490' S & 2070' E FROM NW CORNER SEC. 33
- WELL 3- 750' S & 1980' E FROM NW CORNER SEC. 33
- WELL 4- 740' S & 1890' E FROM NW CORNER SEC. 33

**FINAL PROOF SURVEY**  
UNDER

Application No. G-11604 Permit No. G-10716  
IN NAME OF

ROBERT FESSLER

Surveyed JULY 5 1990, by T.M. WARREN

8-15-90 DSM  
41047-278-126B