


T. 27 S. & 28 S., R. 13 W., W. M.

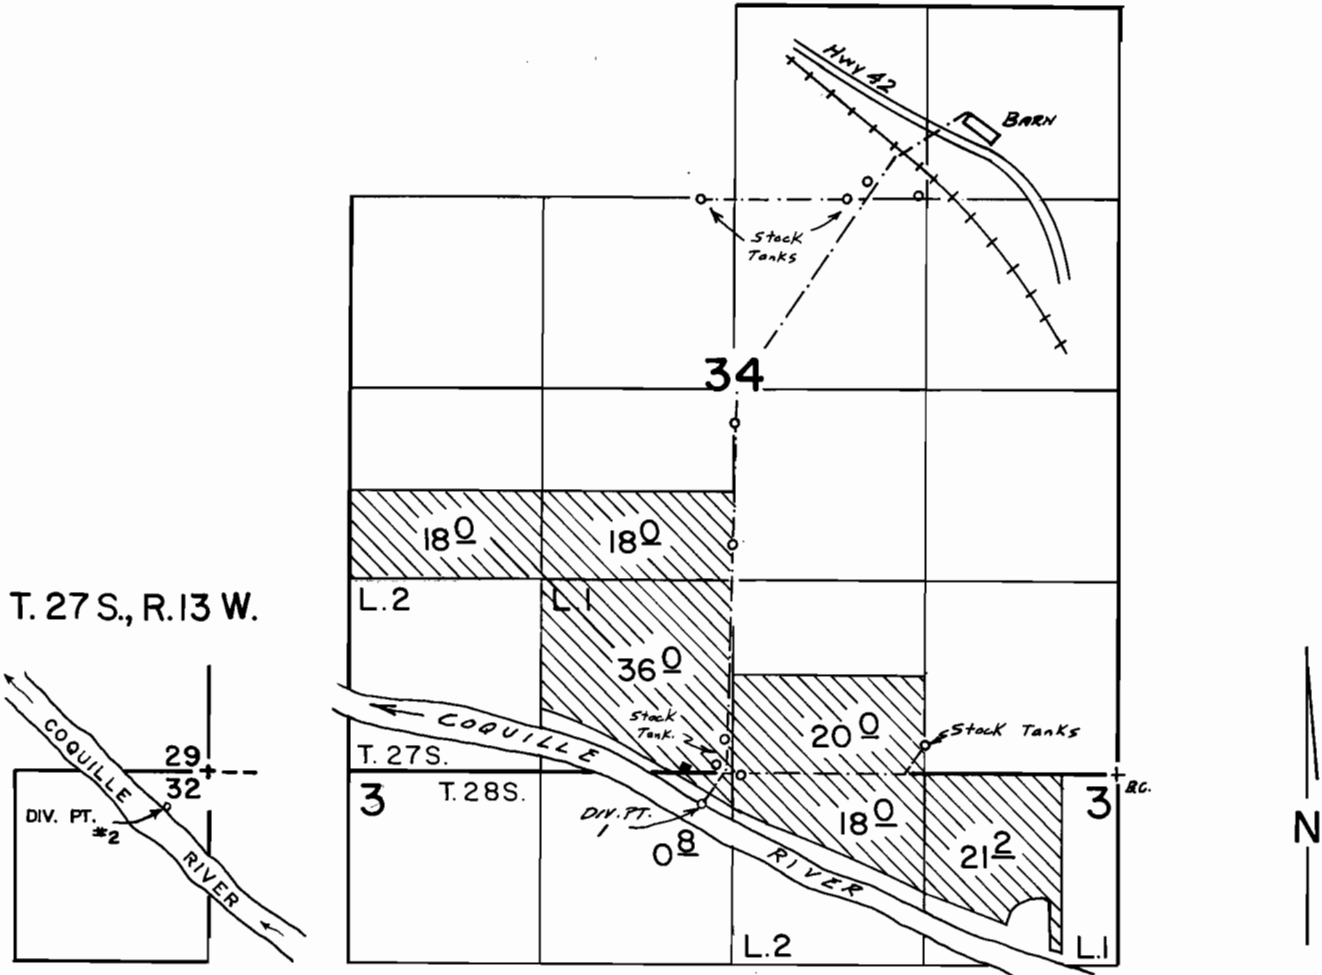

Div. Pt. #1: 200' S & 200' W from North 1/4 Cor. Sec. 3.
 Div. Pt. #2: 260' S & 300' W from Northeast 1/4 Cor. Sec. 32.

Scale: 1" = 1320'

FINAL PROOF SURVEY UNDER

Application No. 54078. Permit No. 41307.....
 IN NAME OF

.....FRED MESSERLE & SONS, INC.

Surveyed Sept. 17, 1990, by B.S. JAMES.....

bsj