


T. 29S., R. 6 W., W. M.

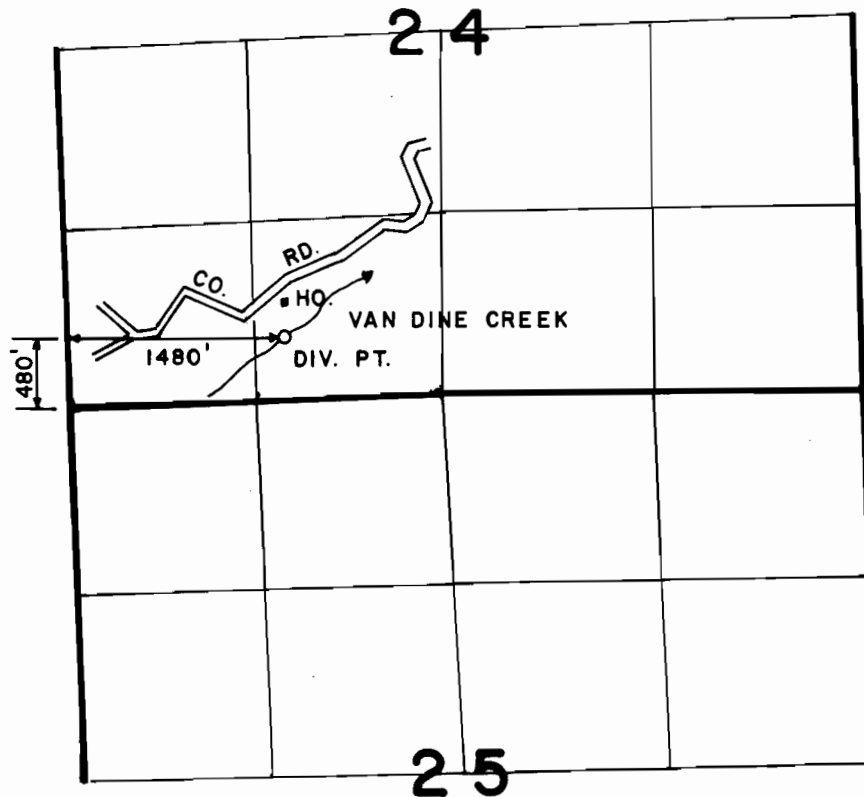

SCALE: 4" = 1 MILE

FINAL PROOF SURVEY UNDER

Application No. 58219 Permit No. 44125.....
IN NAME OF

CECIL DAVIS

Surveyed JULY 16, 1987, by J. M. SCHMORDE