90684

T. 4S., R. 2&3W., W.M.

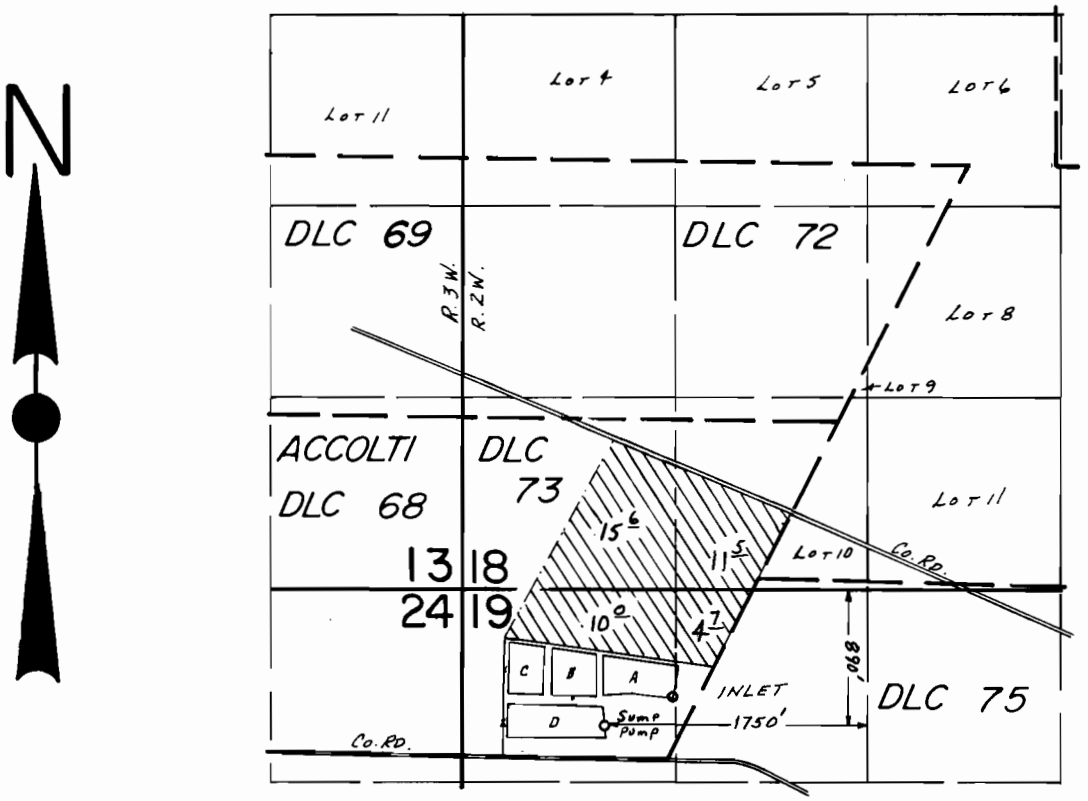

Scale : 1" = 1320'

FINAL PROOF SURVEY
UNDER

Application No. R-61217 61218 Permit No. R-8511 47070

IN NAME OF

CITY OF ST. PAUL

Surveyed AUG. 29 1985, by B.W. BISHOP

41071-178-129B
PTS-1985-L
2/12/88 TMW