
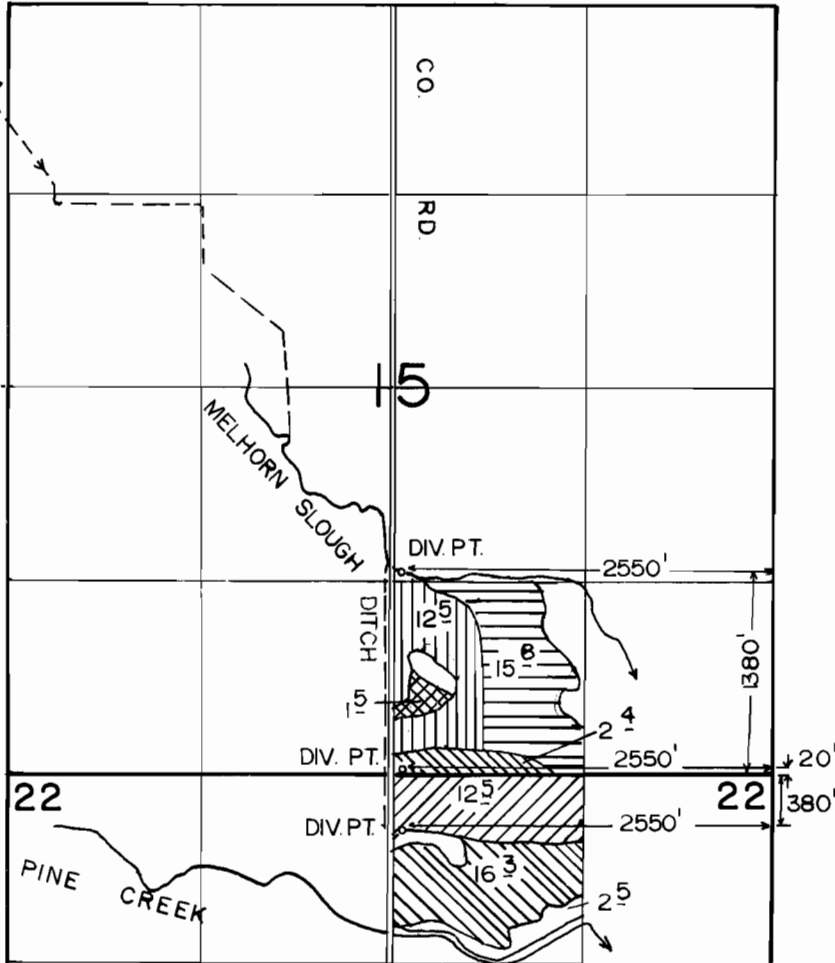


# T. 8 S., R. 46 E., W. M.

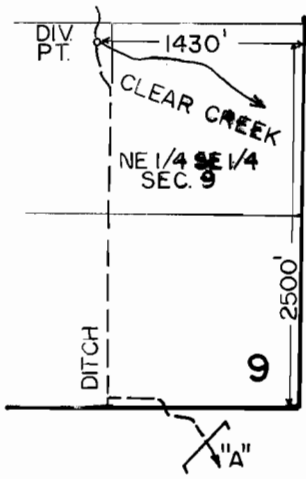

1" = 1320'

- SUPPL. 1870
- SUPPL. 3-6-59
- SUPPL. 1870, 3-6-59, 12-19-77
- SUPPL. 3-6-59, 12-19-77
- PRIMARY
- OVERACREAGE

## FINAL PROOF SURVEY UNDER

Application No. 68461 Permit No. 49556

IN NAME OF

J. V. THOMAS

Surveyed AUGUST 9 1990, by K. KEMP

1-28-91 DSM  
BBB 2KK 144