


T. 7 S., R. 38 E., W.M.

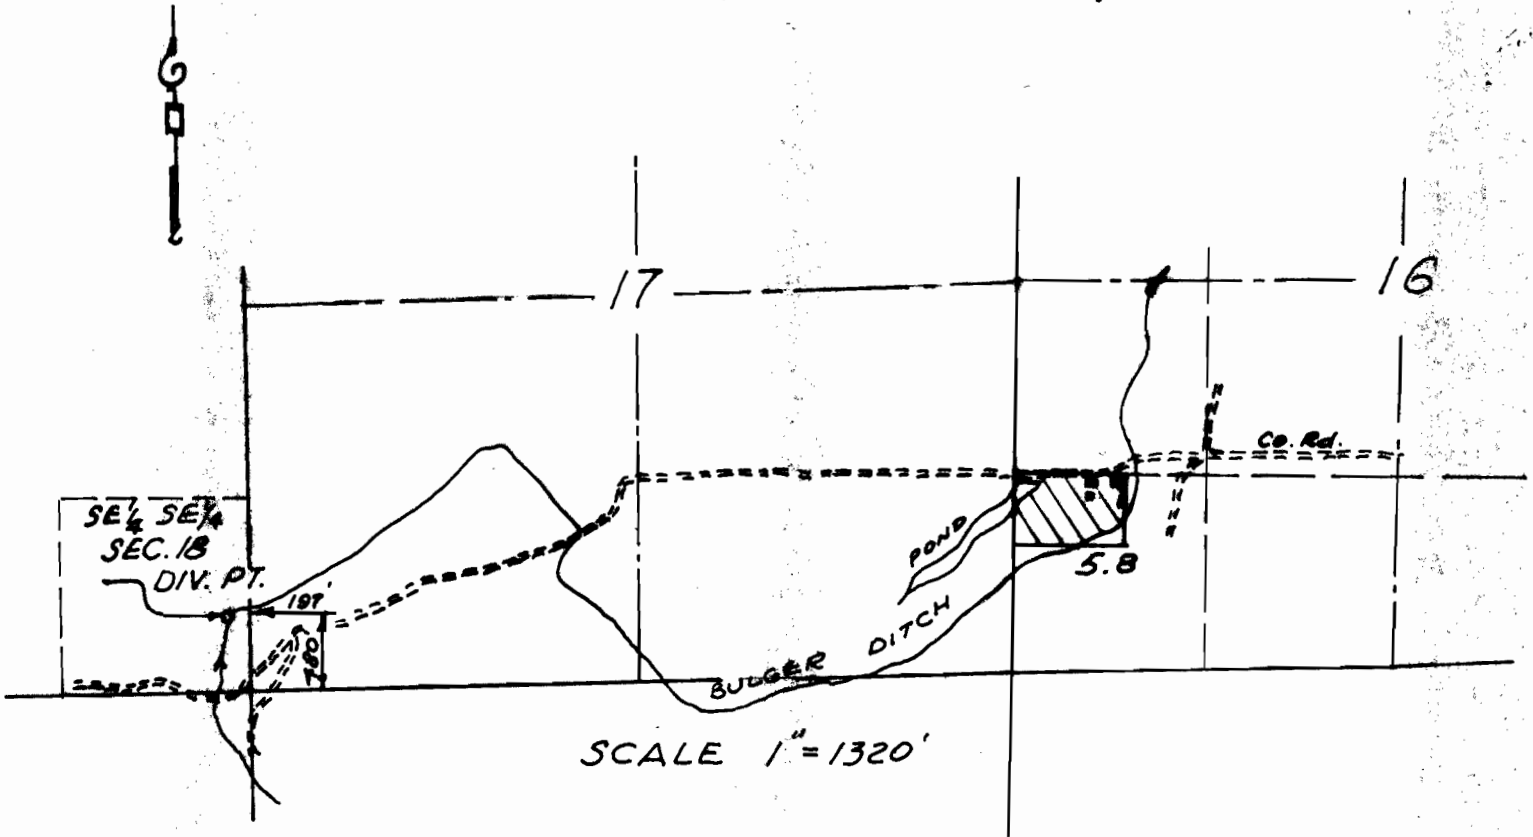

THE PURPOSE OF THIS MAP IS FOR IDENTIFYING THE LOCATION OF THE WATER RIGHT ONLY AND IS NOT INTENDED TO PROVIDE LEGAL DIMENSIONS OF PROPERTY OWNERSHIP LINES.

FINAL PROOF SURVEY UNDER

Application No. 69288 Permit No. 50413

IN NAME OF

RICHARD L. LIEN

Surveyed September 15, 1991

