


The purpose of this map is to identify the location of the water right and is not intended to provide legal dimensions of location of property ownership lines

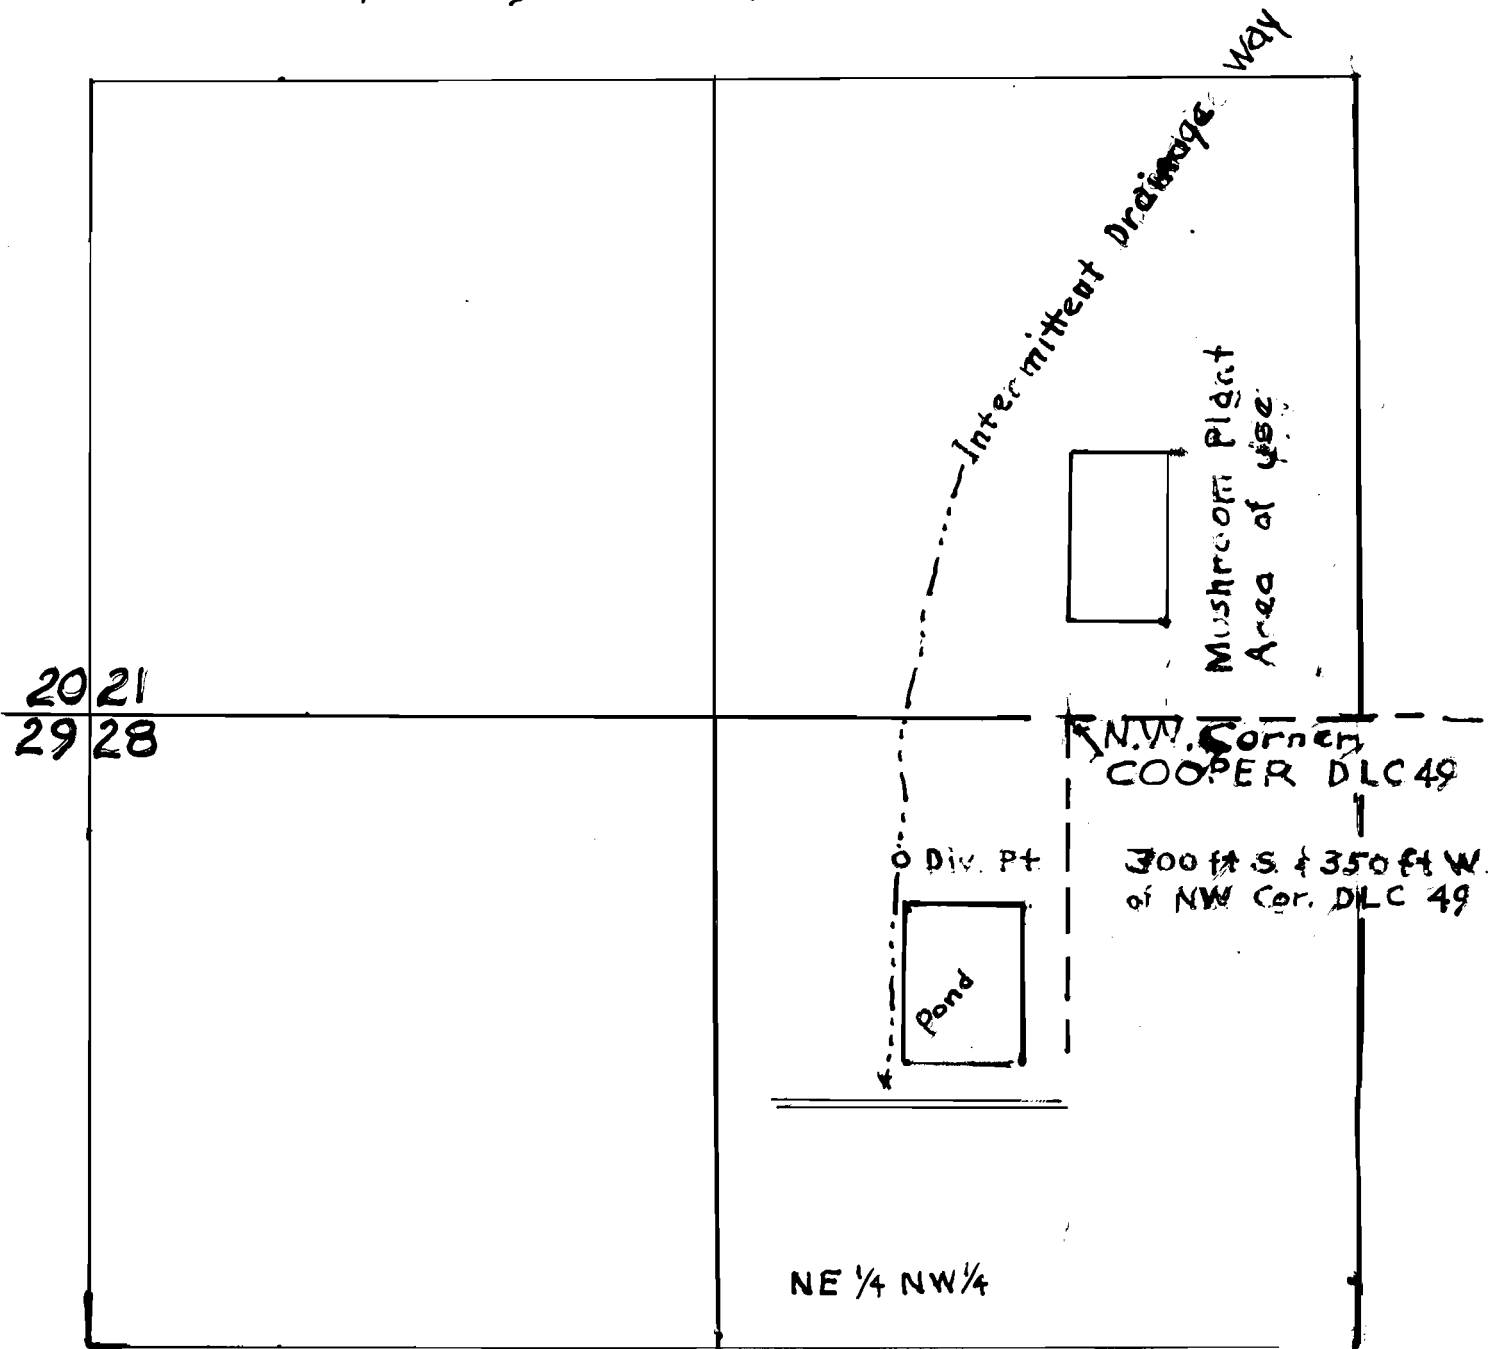

Appl Nos R-69568 & 69569
Permit Nos R10901 & 50219

ROBERT W DARM

FINAL PROOF SURVEY

Robert Darm
1" = 400'

